


Section 23 Township 24 Range 33-W

Well No. #1 Tait "G"

Company Cities Service

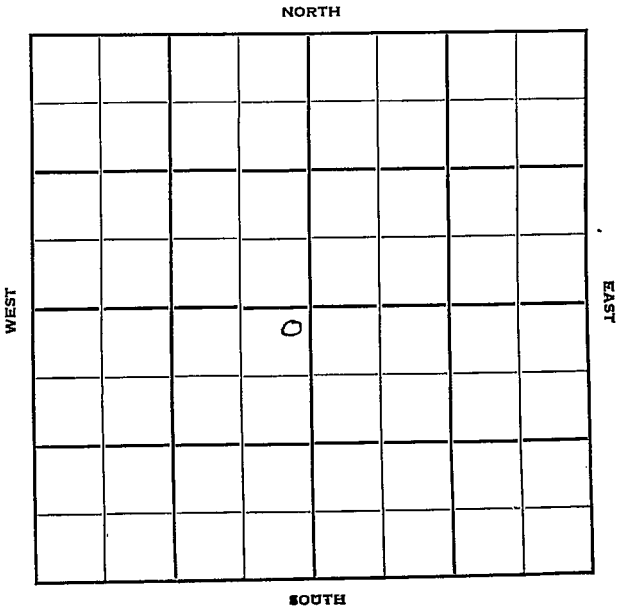

Finney

Sec. 23 Twp. 24 R. 33W

Well No. #1 Tait "G" Farm

Cities Service

Company

Contractor

Hugoton Pool


150' Ft. from N. Line

Ft. from S. Line

150' Ft. from E. Line

Ft. from W. Line

NE SW

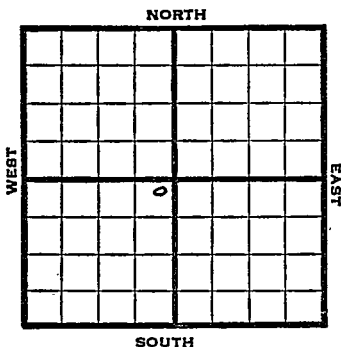

1950

Elev 2875

REPORT

9/20

Spud 9-15-50

8" @ 800'

Drlg. 1153'

10/25

8" @ 800

5" @ 2709

TD 2710

Her 2512

Krider 2540

Win 2618

Ft. Riley 2660

96/2542-58, 96/2564-80

96/2610-26

15000 total acid

Comp 2,070,000 gas 424#

TD 2710

Completed

COMPLETED

J. E. TYRA

J. E. TYRA