


Section 23 Township 24 Range 35WWell No. #1 BardwellCompany Stanolind

NORTH

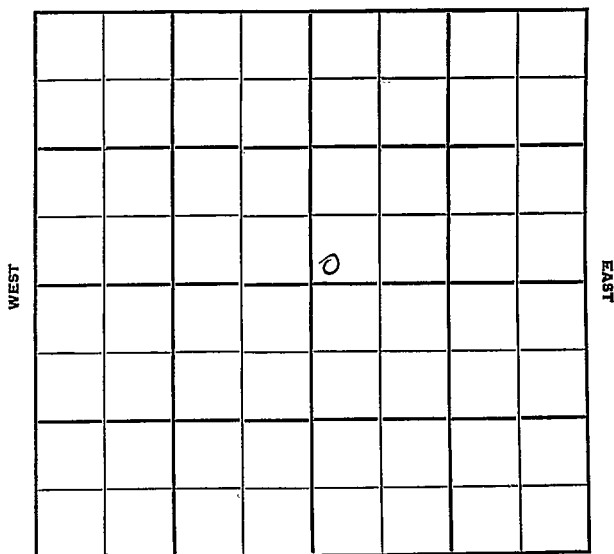

SOUTH

Kearny KANSAS

Sec. 23 Twp. 24 R. 35W

Well No. #1 Bardwell Farm

Stanolind Company

Contractor

Hugoton Pool


Ft. from N. Line

150' Ft. from S. Line

Ft. from E. Line

150' Ft. from W. Line

SW NE

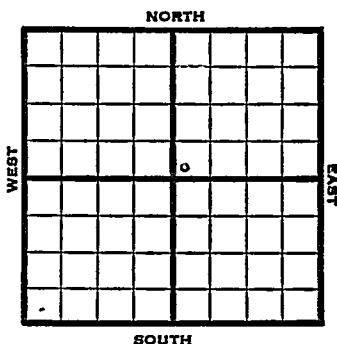

1951 Elev. 2946' REPORT

4/11 Location

5/29 Gas Well TD 2647
10" @ 500 Krider 2436
Win. 2494 Ft. Riley 2554
TD 2647 6" @ 2613
2500 A 180/2442-72 102/2498-2515
36/2554-60 36/2564-70 78/2574-87
46,000 A Comp. 19,000,000 gas

COMPLETE

J. E. TYRA

County Kearny State Kansas

Sec. 23 (Blk. Twp.) 24 (Sur. Rge.) 35W Map No.

Operator Stanolind

Well No. 1 Farm Bardwell

Elev.	2946	Location	SW NE
-------	------	----------	-------

150 Ft. From S Line NE

150 Ft. From W Line Quarter

1st. Report

Completion MAY 29 1951

Remarks Hugoton Pool

Spudding Date

Drig. Data Gas well TD 2647

10" @ 500 Krider 2436 Win. 2494

Ft. Riley 2554 TD 2647 6" @ 2613

2500 A 180/.2442-72 102/ 2498-2515

36/ 2554-60 36/ 2564-70 78/ 2574-87

46000 A Coomp. 19,000,000 gas

J. E. TYRA