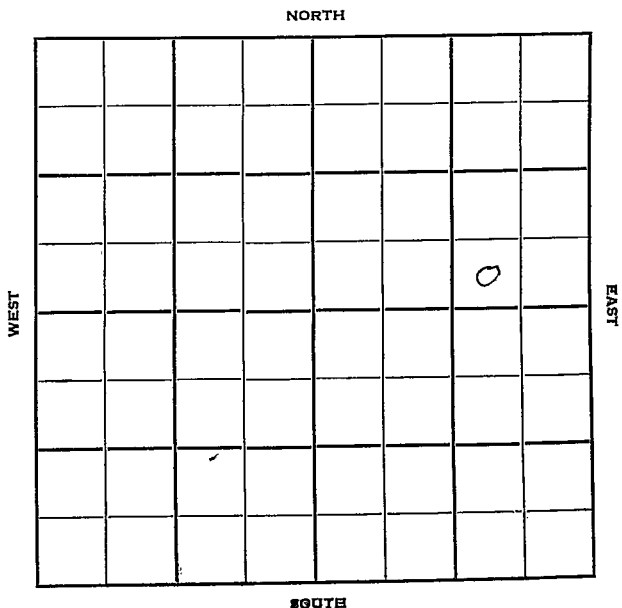


Section 24 Township 24 Range 8WWell No. #6 LoveCompany Geo. Seigrist

Sec. 24 Twp. 24 R. 8W

Well No. #6 Love Farm

Geo. Seigrist Company

Abbeyville Pool Contractor


 Ft. from N. Line

330' Ft. from S. Line

990' Ft. from E. Line

 Ft. from W. Line

SW SE NE

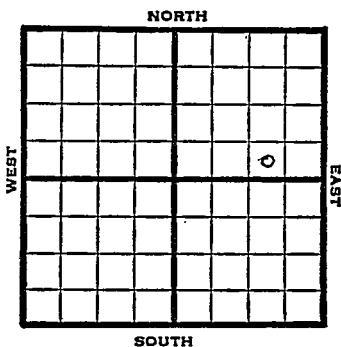

1950 Elev. 1630' REPORT

1/25 Spud 1-17-50
8" @ 156

3/1 Drlg. 2100'
8" @ 156'
4" @ 3526'
Lans 3192'
TD 3550'
D&A

ABANDONED

Kansas

Abbeyville Pool

Map No. _____ Sec. 24 Twp. 24 R. 8W


Well No. 6 Love

Geo. Seigrist Company

Contractor

SW SE NE

SECTION PLAT

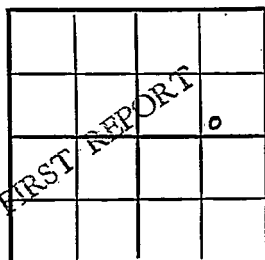

_____ Ft. from N. Line

330 _____ Ft. from S. Line

990 _____ Ft. from E. Line

_____ Ft. from W. Line

Reno County

RECORD

Location _____

Rig up _____

Drilling and Remarks:

Spud 1-17-50

8" @ 156

drlg. 2100

Cased _____ in., _____ ft.

Sand _____

Gas _____

Oil _____

Total Depth _____

PRODUCTION

1st 24 hrs. Nat. _____

1st 24 hrs. after shot _____

Gas _____ Cu. Ft.

Dry Hole _____

Abandoned _____

Date

JAN 25 1950 19

J. E. TYRA

Scout

Kansas

Map No. _____ Sec. 24 Twp. 24 R. 8WWell No. 6 Love_____
Geo. Seigrist _____ Company_____
Contractor

SW SE NE

E1, 16 30
SECTION PLAT_____
Ft. from N. Line330 Ft. from S. Line990 Ft. from E. Line_____
Ft. from W. Line

ABANDONED			
			o

Reno County

Location _____

Rig up _____

Drilling and Remarks:

8" @ 1564" @ 3526Loss 3192D & A.

RECORD

Cased _____ in., _____ ft.

Sand _____

Gas _____

Oil _____

Total Depth 3550

PRODUCTION

1st 24 hrs. Nat. _____

1st 24 hrs. after shot _____

Gas _____ Cu. Ft.

Dry Hole _____

Abandoned _____

Date

MAR 1 195019J. E. TYRA

Scout