

KANSAS

Reno


FORM 51 5M 4-41 PETROL

Section 24 Township 24 Range 8-W

Well No. 2 Linscheid

Company Skelly oil

NORTH Abbyville pool

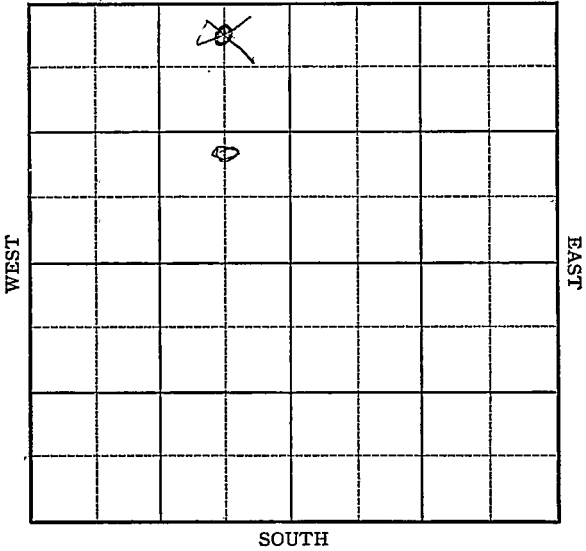

1941

10/22

Lans. 3194'

5" - 3535'

T.D. 3548'

72 shots 3497-3526 $\frac{1}{2}$ '

4500 acid.

Pump 14 oil & 46 water

36.5 Gravity

COMPLETED

Map No. 41 Sec. 24 Twp. 24 R. 8WWell No. 2 LinscheidSkelly Oil

Company

FIRST REPORT

Contractor

SECTION PLAT

C N L NE NW

330 Ft. from N. Line Ft. from S. Line660 Ft. from E. Line Ft. from W. Line

ABBYVILLE POOL

Location Rig up Drilling and Remarks: Derrick

RECORD

Cased in., ft.Sand Gas Oil Total Depth

PRODUCTION

1st 24 hrs. Nat. 1st 24 hrs. after shot Gas Cu. Ft.Dry Hole Abandoned

Date

AUG 20 1941 19S. J. LEWIS Scout

Map No. 41 Sec. 24 Twp. 24 R. 8WWell No. 2 LinscheidSkelly Oil

Company

Correction

Contractor

C N L SE NW

SECTION PLAT

	o		

_____ Ft. from N. Line

990 Ft. from S. Line660 Ft. from E. Line

_____ Ft. from W. Line

ABBYVILLE POOL

Location _____

Rig up _____

Drilling and Remarks:

Reported

C N L NE NW

RECORD

Cased _____ in., _____ ft.

Sand _____

Gas _____

Oil _____

Total Depth _____

PRODUCTION

1st 24 hrs. Nat. _____

1st 24 hrs. after shot _____

Gas _____ Cu. Ft.

Dry Hole _____

Abandoned _____

Date

SEP 3 1941 19 _____

S. J. LEWIS Scout

