

KANSAS

Reno

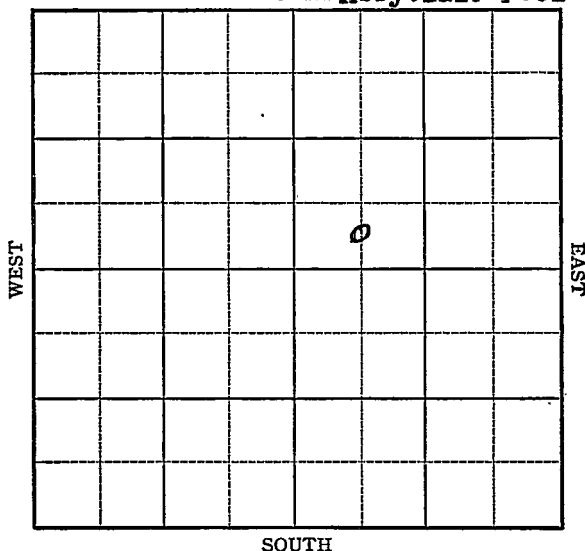
FORM 51 SM 10-41 PETROL

Section 24 Township 24 Range 8-W

Well No. #1 Love

Company Skelly

NORTH Abbyville Pool



Sec. 24 Twp. 24 R. 8-17

(Abbyville)

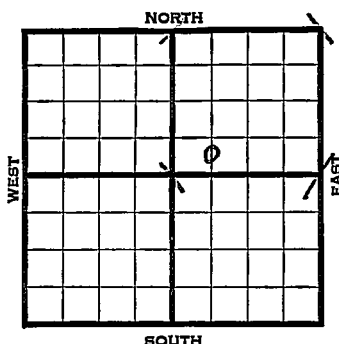
Et. from N. Line

330 _____ Ft. from S. Line

Et. from E. Line

660 _____ Ft. from W. Line

Elev. 1631

[illegible]

KANSAS

Reno

Map No. 41 Sec. 24 Twp. 24 R. 8WWell No. 1 LoveSkelly Company

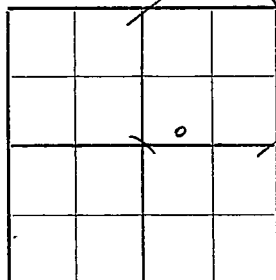
Contractor

FIRST REPORT

C SL SW NE

 Ft. from N. Line330 Ft. from S. Line Ft. from E. Line660 Ft. from W. Line**ABBYVILLE POOL**

SECTION PLAT

Location Rig up

Drilling and Remarks:

Derrick**RECORD**Cased in., ft.Sand Gas Oil Total Depth **PRODUCTION**1st 24 hrs. Nat. 1st 24 hrs. after shot Gas Cu. Ft.Dry Hole Abandoned

Date

DEC 17 1941

19

S. J. LEWIS Scout

Reno

KANSASMap No. 41 Sec. 24 Twp. 24 R. 8WWell No. 1 LoveSkelly

Company

COMPLETED

Contractor

C SL SW NE

 Ft. from N. Line330 Ft. from S. Line Ft. from E. Line660 Ft. from W. Line

SECTION PLAT

ABBYVILLE POOL

Location Rig up

Drilling and Remarks:

Lease 3190
5" C 3528 1/2
7000 cu ft
Pump 877 P.S.
280 G.P.M.

RECORD

Cased in., ft.Sand Gas Oil Total Depth 3543

PRODUCTION

1st 24 hrs. Nat. 1st 24 hrs. after shot Gas Cu. Ft.Dry Hole Abandoned

Date

JAN 28 1942

19

S. J. LEWIS

Scout