


KANSAS

Stafford

Section 24 Township 24 Range 11-W

Well No. #4 McComb

Company Derby

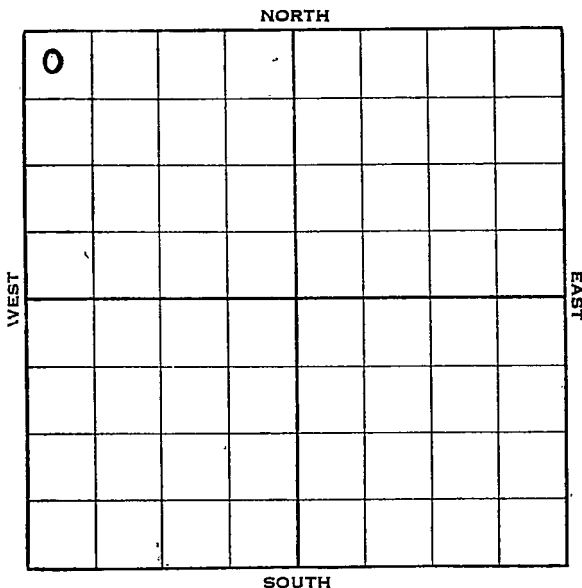

1938

9/14 7" - 3796'.

Misener 3796'.

T. D. 3821'.

Shot 11 qts.

Potential 3640 bbls.

COMPLETED

Stafford KANSASMap No. 47 Sec. 24 Twp. 24 R. 11WWell No. 4 McCombDerby

Company

Contractor

FIRST REPORT**SECTION PLAT**330 NW/C
Ft. from N. Line

Ft. from S. Line

Ft. from E. Line

330
Ft. from W. Line

0			

Location

Rig up

Drilling and Remarks:

Cellar**RECORD**

Cased _____ in., _____ ft.

Sand _____

Gas _____

Oil _____

Total Depth _____

PRODUCTION

1st 24 hrs. Nat. _____

1st 24 hrs. after shot _____

Gas _____ Cu. Ft.

Dry Hole _____

Abandoned _____

Date

H. D. HatfieldJUN 29 1938 19

Scout

Stafford KANSAS

Map No. 47 Sec. 24 Twp. 24 R. 11WWell No. 4 McCombDerby Company Contractor

. COMPLETED

NW/C

SECTION PLAT

330 Ft. from N. Line Ft. from S. Line Ft. from E. Line330 Ft. from W. Line

0			

Location Rig up

Drilling and Remarks:

*Shot 11 gts**POT 3640*

RECORD

Cased 7 in., 3796 ft.Sand Misener 3796Gas Oil Total Depth 3821

PRODUCTION

1st 24 hrs. Nat. 1st 24 hrs. after shot Gas Cu. Ft.Dry Hole Abandoned

Date

SEP 14 1938

19

H. D. Hatfield Scout