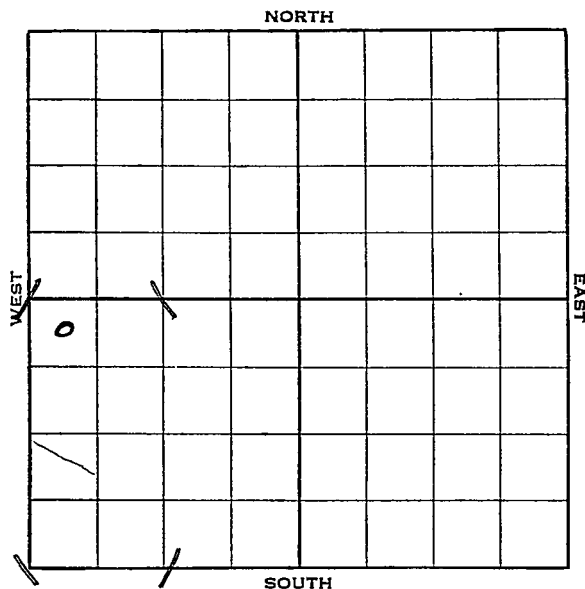
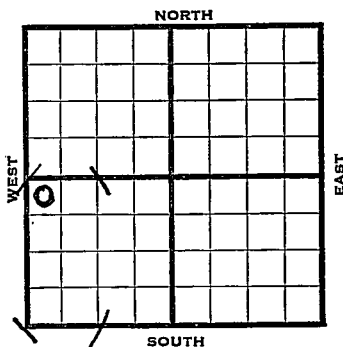


Section 24 Township 24 Range 11-WWell No. #1 E. McCombCompany Sinclair-Prairie

KANSAS

Stafford

Sec. 24 Twp. 24 R. 11-WWell No. #1 E. McComb Farm
Sinclair-Prairie Company330 Ft. from N. Line Ft. from S. Line Ft. from E. Line330 Ft. from W. Line

1938	REPORT
4/20	Location
4/29	R U R
5/6	12" @ 215'. Drlg. 1800'.
5/12	Drlg. 3025'.
5/20	Lans. 3408'.
	Base Kinderhook 3794'.
	Misner 3799'. T.D. 3800' S. O.
	Rng. 7".
5/27	7" @ 3795'. Coring 3808'.
6/3	T.D. 3812'. Flowed 402 oil
	in 12 hrs. Shot 12 qts.
6/10	T.D. 3812'. Flowed 402 oil in
	12 hrs. Shot 12 qts.
	Rng. tubing.
6/17	SD 3812'.
6/24	" "
7/1	" "
7/8	" "
	OVER

1938

7/13

7" -- 3795' .

Misner 3799'.

T. D. 3812'.

Shot 12 qts.

Flowed 204 bbls. 4 hrs. & 134
bbls. 4 hrs.

Potential 804 bbls.

COMPLETED

Stafford **KANSAS**Map No. 47 Sec. 24 Twp. 24 R. 11WWell No. 1 E. McCombSinclair Prairie

Company

Contractor


FIRST REPORT

NW SW

330 Ft. from N. Line

Ft. from S. Line

Ft. from E. Line

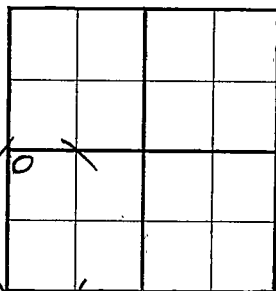330 Ft. from W. Line**SECTION PLAT**Location X

Rig up

Drilling and Remarks:

RECORD

Cased _____ in., _____ ft.

Sand _____

Gas _____

Oil _____

Total Depth _____

PRODUCTION

1st 24 hrs. Nat. _____

1st 24 hrs. after shot _____

Gas _____ Cu. Ft.

Dry Hole _____

Abandoned _____

Date

APR 20 1938 19

H. D. Hatfield

Scout

Stafford KANSAS

Map No. 47 ~~46~~ Sec. 24 Twp. 24 R. 11WWell No. 1 E. McCombSinclair Prairie

Company

Contractor

COMPLETED

NW SW

330 Ft. from N. Line

_____ Ft. from S. Line

_____ Ft. from E. Line

330 Ft. from W. Line

SECTION PLAT

0			

Location _____

Rig up _____

Drilling and Remarks:

*Shot 12 gts**Flowed 204/4 134/4**POT 804*

RECORD

Cased 7 in., 3795 ft.Sand Misener 3799

Gas _____

Oil _____

Total Depth 3812

PRODUCTION

1st 24 hrs. Nat. _____

1st 24 hrs. after shot _____

Gas _____ Cu. Ft.

Dry Hole _____

Abandoned _____

Date

JUL 13 1938

19

H. D. Hatfield Scout