

Stafford


KANSAS

Form 51-5M-11-38-Palace

Section 24 Township 24 Range 11-W

Well No. 1 Wallace

Company ~~Bernsdall~~ E.H. Moore

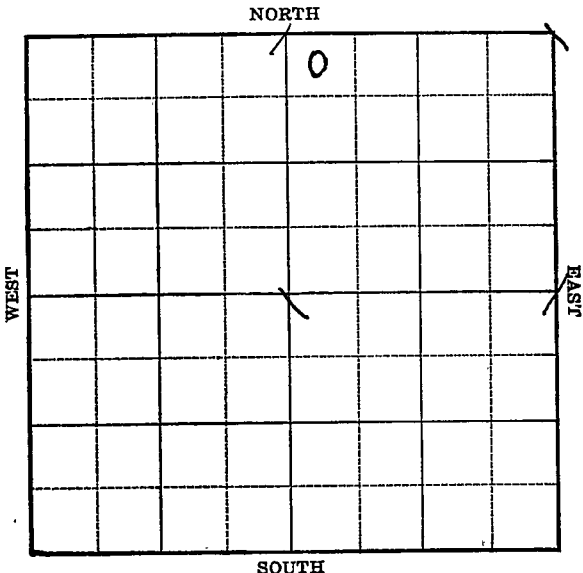

Stafford KANSAS

Map No. 47 Sec. 24 Twp. 24 R. 11WWell No. 1 WallaceBarnsdall Company


Contractor

FIRST REPORT

NW NE

330 Ft. from N. Line Ft. from S. Line Ft. from E. Line330 Ft. from W. Line

SECTION PLAT

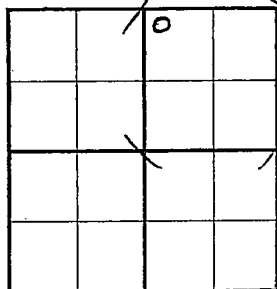Location Rig up

Drilling and Remarks:

Cellar

RECORD

Cased in., ft.Sand Gas Oil Total Depth

PRODUCTION

1st 24 hrs. Nat. 1st 24 hrs. after shot Gas Cu. Ft.Dry Hole Abandoned

Date

NOV 30 1922H. D. Hatfield

Scout

Stafford KANSASMap No. *47* Sec. *24* Twp. *24* R. *11^W*Well No. *1 - Wallace**E. H. Moore* Company

Contractor

CORRECTION SECTION PLAT


330 Ft. from N. Line

_____ Ft. from S. Line

_____ Ft. from E. Line

330 Ft. from W. Line

CORRECTION

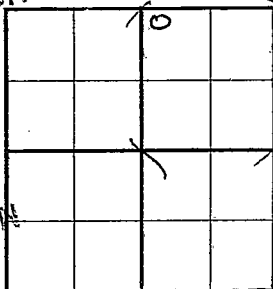

Location _____

RECORD

Cased _____ in., _____ ft.

Sand _____

Gas _____

Oil _____

Total Depth _____

PRODUCTION

1st 24 hrs. Nat. _____

1st 24 hrs. after shot _____

Gas _____ Cu. Ft.

Dry Hole _____

Abandoned _____

Date

DEC 13 1938₁₉

H. D. Hatfield Scout

*first reported
as Barnsdall
but they have
made a deal
with Moore to
take over the lease*

Stafford

KANSAS

Map No. _____ Sec. 24 Twp. 24 R. 11WWell No. 1 WallaceE. H. Moore

Company

Contractor

ABANDONED

NW NE

330 Ft. from N. Line

_____ Ft. from S. Line

_____ Ft. from E. Line

330 Ft. from W. Line

SECTION PLAT

		0	

ZENITH POOL

Location _____

Rig up _____

Drilling and Remarks:

HFW

D & A

RECORD

Cased 7 in. 3799 ft.Sand Misener 3798

Gas _____

Oil _____

Total Depth 3812

PRODUCTION

1st 24 hrs. Nat. _____

1st 24 hrs. after shot _____

Gas _____ Cu. Ft.

Dry Hole _____

Abandoned _____

Date

JAN 11 1932

19

H. D. Hatfield

Scout