

Section 24 Township 24 Range 14WWell No. #1 KoelachCompany White Eagle

NORTH

0							

WEST

EAST

SOUTH

Stafford KANSAS

Sec. 24 Twp. 24 R. 14 W

Well No. # 1 Koelsch Farm

White Eagle Company

Hilton Contractor

Wildcat

Ft. from N. Line


330 Ft. from S. Line

Ft. from E. Line

330 Ft. from W. Line

SW SW SW

Shell \$3,000.00

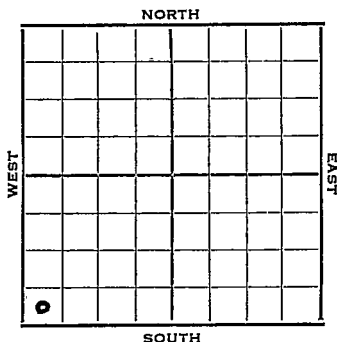

1952 Elev. 1942' REPORT

9/17 Spud 9-12-52
10" @ 280' Anhy 840'
Drlg. 1796'

9/24 Heeb. 3458 Br Li 3591
Lans KC 3620
DST 3687-3705 1 hr. 30' SOCM & 270'
SW 1150# DST 3742-58

10/1 DST 3742-58, 1 hr. 500' clean oil
130' gassy oil, FP 550# 1350#
DST 3779-88, 1 1/2 hr. 40' OCW 110#
BKC 3890 Cong. 3951
V 4027 Simp. 4187
Arb. 4240
RTD 4290 5" @ 4010'

10/8 12/ 3950-54 20/ 3964-76 NS
SP 3820 48/ 3750-58 S/ 5 boph
2000 A F/ 22 bo

10/15 F 50 BOPH 3/4" ch

10/22 Spud 9-12-52
Oil well TD 4290' 10" @ 280
Anhy 840' Heeb 3458' Br. lime 3591
Lans. 3620'
DST 3687-3705 open 1 hr. rec 30' SOCM
270' SW 1150#
DST 3742-58 open 1 hr, rec 500' clean
oil, 130' gassy oil 1350#

OVER

1952

10/22

(Information continued)

DST 3779-88 open $1\frac{1}{2}$ hr, rec 40' OCW

110# B KC 3890' Cong. 3951'

Viola 4027' Simp. 4187' Arb. 4240'

TD 4290' 5" @ 4010 12/3950-54

20/3964-76 SP 3820 48/3750-58

S/5 BOPH 2000 A F/22 BO


F/208 BO 5 hr. F/50 BOPH

Comp. 2583 BOPD

COMPLETED

J. G. McGEHEE

County Stafford State Kansas
 Sec. 24 (Blk.) 24 (Sur.) 14W Map No.
 Operator White Eagle
 Well No. 1 Farm Koelsch
 Elev. 1947 Location SW SW SW

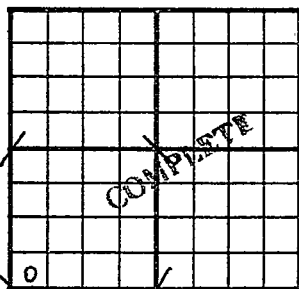

330 Ft. From S Line SW
330 Ft. From W Line Quarter

Ist. Report

Completion OCT 22 1955

Remarks Wildcat

Hilton - Contr.

Spudding Date 9-12-52

Drig. Data Oil well TD 4290

10" @ 280 Anhy. 840 Heeb. 3458

Br. lime 3591 Lans. 3620 DST 3687-3705

open 1 hr. Rec. 30' soem 270' sw

1150# DST 3742-58 open 1 hr. Rec.

500' clean oil 130' gassy oil 1350#

DST 3779-88 open 1½ hr. Rec. 40' ocw

110# B KC 3890 Cong. 3951 Viola 4027

Simp. 4187 Arb. 4240 TD 4290 5" @ 4010

12/ 3950-54 20/ 3964-76 SP 3820

48/ 3750-58 S/ 5 boph 2000 A

F/ 22 bo F/ 208 bo 5 hr. F/ 50 boph

Comp. 2583 bopd