

O.W.D.D

Sec. 24 Twp. 24 R. 14 W

Well No. # 3 Koelsch Farm

Helmerich & Payne Inc. Company

Hilton Drlg. Contractor

Koelsch Pool


_____ Ft. from N. Line

330 Ft. from S. Line

990 Ft. from E. Line

_____ Ft. from W. Line

SW SE SW

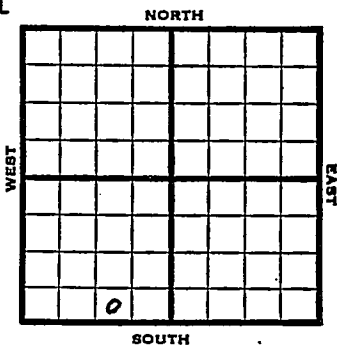

1953

Elev. 1945' REPORT

- 5/6 Location
- 5/21 "
- 5/28 Anhy 835
8" @ 844
Drlg. 1417'
- 6/3 Heeb 3469' Br li 3603 KC 3 633
Drlg. 3710
- 6/10 Spud 5-23-53 D & A TD 3879'
Anhy 835 8" @ 844 Heeb 3469
Br line 3606 KC 3 633
TD 3879' D & A

ABANDONED.

O.W.D.D

1953

9/9 Lans 3633
OTD 3879
to DD for SWD

9/30 Re-cement

10/28 CO 4316

11/4 N.R.

12/9 NR

OVER

1953
12/16

SWD Well

TD 4316'

Lans 3633'

OTD 3879'

Cong 3977', Viola 4051', Simp 4190',
Arb. 4249'

TD 4316'

5" @ 4300'

CO to 4316'

S/2 $\frac{1}{2}$ bwph 250A

S/25 gwph

Comp. SWD Well 200 bswph

ABANDONED

