


Section 24 Township 24 Range 14 W

Well No. # 4 Koelsch

Company Helmerich & Payne

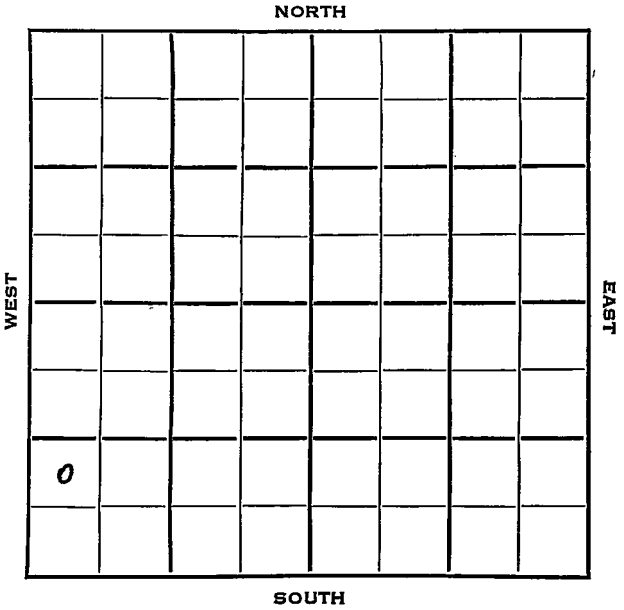

Sec. 24 Twp. 24 R. 14W

Well No. #4 Koelsch Farm

Helmerich & Payne Company

Hilton Drlg. Contractor
Koelsch Pool


 Ft. from N. Line

990 Ft. from S. Line

 Ft. from E. Line

330 Ft. from W. Line

NW SW SW

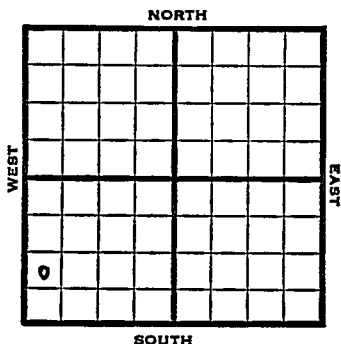

		REPORT
1953	Elev. 1947'	
6/10	Spud 6-4-53 8" @ 844' Anhy 835 Drlg. 2147'	
6/24	Heeb 3454, Br li 3587, KC 3613 DST 3687-95, 1 hr., 1140' oil, 60' W, 1165# 20" RTD 3905 5" @ 3904 CO 3804, 40/3740-48, 4 BOPH 12hrs. F 100 BO 1½ hrs.	
7/1	Spud 6-4-53 Oil Well TD 3905 8" @ 844' Anhy 835, Heeb 3454, Br lime 3587, KC 3613 DST 3687-95, opn 1hr., rec. 1140' oil, 60' wtr., 1165# TD 3905 5" @ 3904 CO to 3804, 40/3740-48, 4 boph 12 hrs. F/100 bo 1½ hrs. Comp. 1139 bopd	

J. G. McGEHEE

J. G. McGEHEE