


DX 78-1 Stafford

KANSAS

Section 24 Township 24 Range 14W

Well No. 6 Koelsch

Company Helmerich & Payne

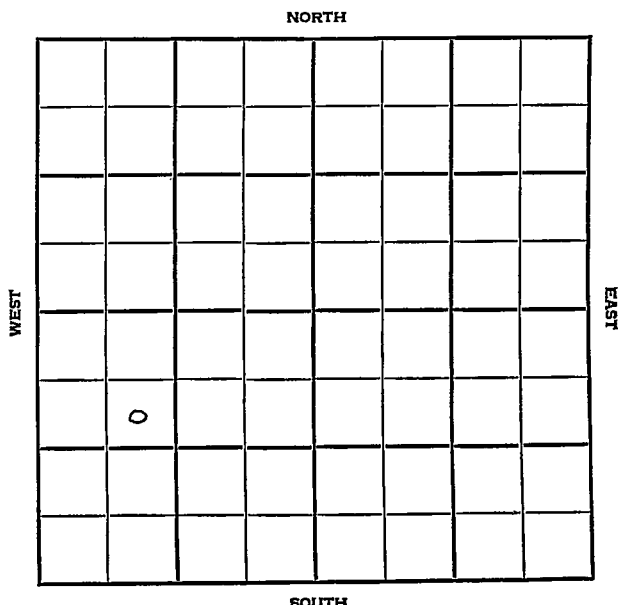

Stafford

KANSAS

SEC.	TWP.	R.
24	24	14 W

WELL NO.

#-6 Koelsch

FARM

COMPANY

Helmerich & Payne

CONTRACTOR

Peel Bros.

Koelsch Pool

990

Ft. from N. Line


Ft. from S. Line

Ft. from E. Line

990

Ft. from W. Line

SE NW SW

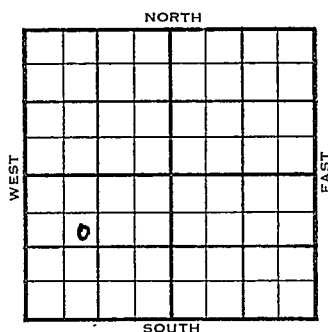

1955

ELEVATION
1946'

REPORT

4/27

Spud 4-18-55

8" @ 832

Drlg. 3415'

6/1

Comm 4-18-55

Anh 825, H 3453, TR 3472, B1 3588

L 3615, BKC 3888, TD 3900

8" @ 832/500 5 1/2" @ 3899 perf/

3764-74, HFW sq 24/3748-54 500 A

S/23 boph

Comp 205 bopd

COMPLETED

3115
1.946
-16.69



Sec. **24** (Blk. Twp.) (**24**) (Sur. Rge.) **14W** Map No.

Well No. **6** Farm **Koelsch**

Elev. 1946 Location SE NW SW

FIRST REPORT

990Ft. From N -Line SW

990 Ft. From W Line Quarter

1st. Report APR 27 1955

Complétion

Remarks

Peel Bros. - Contr.

Spudding Date **4-18-55**

Drlq. Data KoeIsch Pool

8" @ 832 drlg: 3415

FABEN GILSTRAP

County	Stafford	Elev.	1946	Co.	
Sec.	24	Twp.	V24		
		Rge.	14W		
Company	Helmerich & Payne				
Farm Name	Koelsch			No.	6

TOPS	DEPTH	LOG	DATUM	Loc. in Sec.	Lse.
Anh.	825			SE NW SW	
Tp.					
H.	3453		1507		
Tr.	3472		1526		
Dg.					
Bl.	3588		1642		
L.	3615		1669	Geol.	
K.C.				Contr.	
B.K.C.	3888		1942		
Ce.				Peel Bros.	
C.					
M.				Pool	
M.				Koelsch	
K.					
Mz.					
Ma.					
V.					
S.					
S.					
A					
R.					
Pe.					
G.					
T.D.	3900		1954		

Date Comm.	4-18-55	1953	JUN	1	1955	No.
8" @ 832/500	5 1/2" @ 3899	perf/	3764-74			
HFV	sq.	24/-	3748-54	500	A	
S/	23 boph	Comp.	205 bopd			

						T.

						R.