

Stafford.

DX 78-1

KANSAS

Section 24 Township 24 Range 14W

Well No. #1 Mason

Company Glickman Oil

NORTH

	0						

WEST

EAST

SOUTH

Stafford

Kansas

SEC.	TWP.	R.
24	24	11W

WELL NO. #1 Mason FARM

COMPANY Glickman Oil

CONTRACTOR B & B


Koelsch Pool

\_\_\_\_\_ Ft. from N. Line

330 \_\_\_\_\_ Ft. from S. Line

\_\_\_\_\_ Ft. from E. Line

330 \_\_\_\_\_ Ft. from W. Line

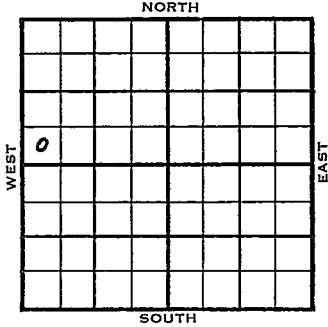

SW SW NW

	ELEVATION	REPORT
1954	1939'	

12/1 Spud 11-27-54  
8" @ 231'  
Drlg. 2635'

12/15 Spud 11-27-54 D & A TD 4255  
8" @ 231' Heeb 3457 Br line 3593  
Lans. 3618  
DST 3694-3702 open 1 hr rec 190' SW  
1050# DST 3751-58 open 1 hr rec 30'  
mud. 40#  
DST 3779-3803 open 1 hr rec 40' muddy  
SW 1200# B KC 3889 Cong 3966  
Viola 4017 Simp. 4171 Arb. 4223  
TD 4255 D & A

**ABANDONED**

County Stafford State Kansas

Sec. 24 (Blk. Twp.) 24 (Sur. Rge.) 14W Map No.

Operator Glickman Oil

Well No. 1 Farm Mason

Elev. Location SW SW NW


330 Ft. From S Line NW

330 Ft. From W Line Quarter

1st. Report DEC 1 1954

Completion

Remarks

B & B - Contr.

Spudding Date 11-27-54

Drlg. Data Koelsch Pool

8" @ 231 drlg. 2635

FABEN GILSTRAP

County Stafford State Kansas

Sec. 24 (Blk. 24) (Sur. 14W) Map No.

Operator Glickmen Oil

Well No. 1 Farm Mason

Elev. 1939 Location SW SNNW


330Ft. From S Line NW

330Ft. From W Line Quarter

Ist. Report

Completion DEC 15 1954

Remarks Koelsch Pool

B & B - Contr.

Spudding Date 11-27-54

Drlg. Data D & A TD 4255

8" @ 231 Heeb. 3457 Br. line 3593

Lans. 3618 DST 3694-3702 open 1 hr.

Rec. 190' sw 1050# DST 3751-58

open 1 hr. Rec. 30' mud 40#

DST 3779-3803 open 1 hr. Rec. 40' muddy

sw 1200# B KC 3889 Cong. 3966

Viola 4017 Simp. 4171 Arb. 4223

TD 4255

D & A

FABEN GILSTRAP