

Finney


KANSAS

SECTION 24 TOWNSHIP 24 RANGE 32W

WELL NO. #1 John Huston

COMPANY Skelly Oil

NORTH C NE/4

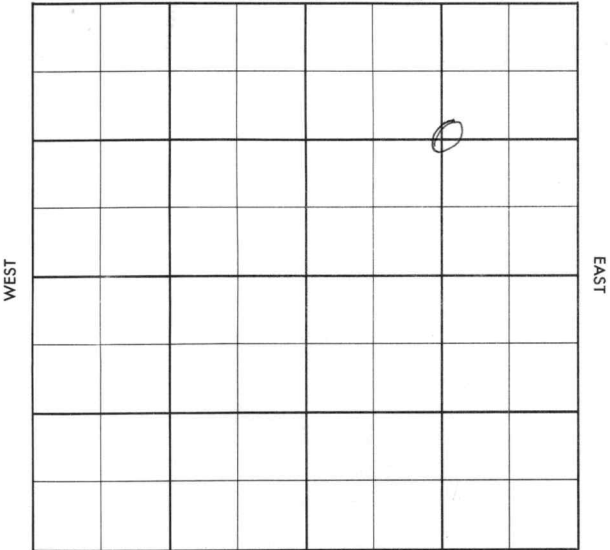

County Finney Elev. _____
 Sec. 24 Twp. 24 Rge. 32W
 Company Skelly Oil
 Farm Name John Huston No. 1

TOPS	DEPTH	LOG	DATUM	Loc. in Sec.
Anh.				<u>C NE/4</u>
Tp.				
H.				
Tr.				
Dg.				
Bl.				
L.				Geol. _____
K.C.				Contr. _____
B.K.C.				<u>Graham-Michael</u>
Ce.				
C.				Pool _____
M.				
M.				
K.				
Mz.				
Mq.				
V.				
S.				
S.				
A.				
R.				
Pe.				
G.				
T.D.	<u>2661</u>			

Date Comm. 1-22-57
8 5/8" @ 520/400 5 1/2" @ 2658

FIRST REPORT

~~35~~

County Finney Elev. 2892
 Sec. 24 Twp. 24 Rge. 32W
 Company Skelly Oil
 Farm Name John Huston No. 1

TOPS	DEPTH	LOG	DATUM	Loc. in Sec.
Anh. <u>Hall</u>		<u>2554</u>		<u>C. NE/4</u>
Tr. <u>Hall</u>		<u>2605</u>		
H. <u>U. Hall</u>		<u>2630</u>		
Tr. <u>U. Hall</u>		<u>2656</u>		
Dg.				
BL.				
L.				Geol.
K.C.				Contr.
B.K.C.				<u>Graham-Michael</u>
Ce.				
C.				
M.				Pool
M.				
K.				
Mz.				
Me.				
V.				
S.				
S.				
A.				
R.				
Pe.				
G.				
T.D.	<u>2661</u>			

COMPLETE

Date Comm. 1-29-578 5/8" @ 520/400 5 1/2" @ 2658 FEB 13 '57

FEB 20 '57

DD 2668 SS G TSTMFRAC 3x3 fst 1.125 MCFG + 15GWPH PB 2650 48/2636-449a 1 MIN CFA CA 2668 9a1.200 MCFG FRAC 9x9 9a916 MCFG + Water Thru 5 1/2" CS9a. 1.646 MCFG + 6d S.I. 27 '57MAR 6 '57 9a 4.30 MCFG RP 450#