


Section 24 Township 24 Range 33W
~~32W~~

Well No. #1 State Refuge

Company Northern Pump

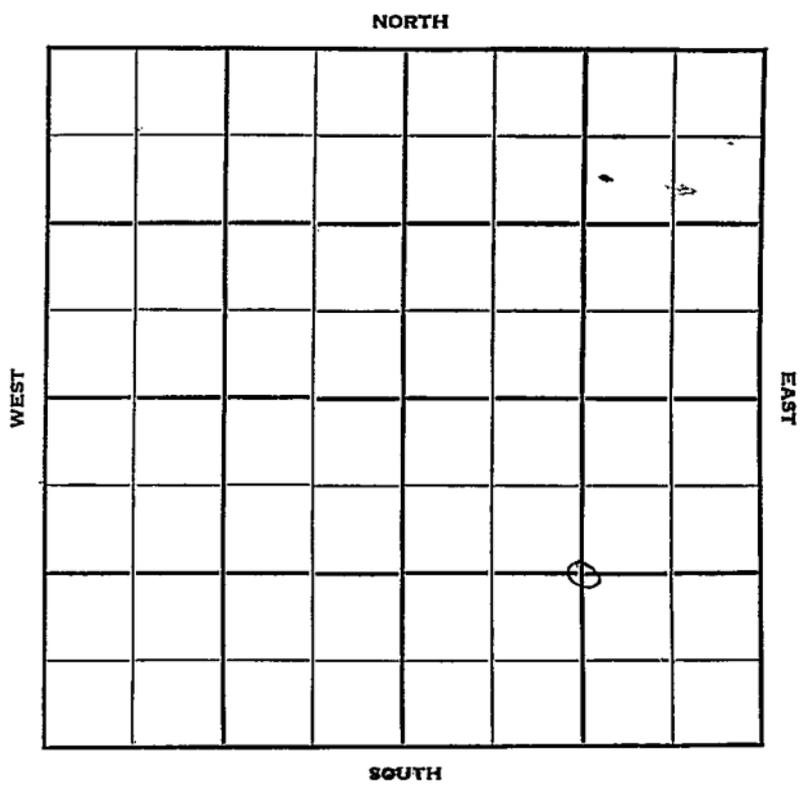

Sec. 24 Twp. 24 R. 33W
~~31E~~

Well No. #1 State Refuge Farm

Northern Bump / Company


Contractor

Ft. from N. Line

1320 Ft. from S. Line

1320 Ft. from E. Line

Ft. from W. Line
C SE/4

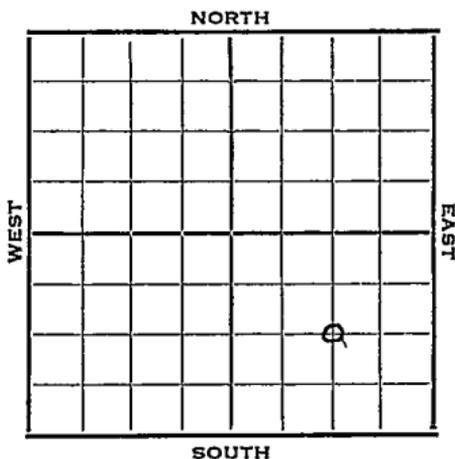

1952

Exp 2864' REPORT

5/28

RU

6/11

NR

6/18

Her 2534' RTD 2536' 7" @ 2535'
DD

6/25

NR

7/2

NR

7/9

TD 2665' 1000 A PB 2645' 3200 A
Kri 2558' Winfield 2588'
Ft. Riley 2650'

7/17

NR

7/23

"

7/30

Spud 5-28-52
Gas Well TD 2665'
10" @ 385 Her. 2534 TD 2665
7" @ 2535 1000 A PB 2645
3200 A Kri 2558 Win. 2588
Ft. Riley 2650
Comp. 5,433,000 gas 407#

COMPLETED

County Finney State Kansas

Sec. 24 (Blk. Twp.) 24 (Sur. Rge.) 34W Map No.

Operator Northern Pump

Well No. 1 Farm State Refuge

Elev. _____ Location C SE/4

FIRST REPORT

1320 Ft. From S Line SE

1320 Ft. From E Line Quarter

Ist. Report MAY 28 1952

Completion _____
Remarks See Correction

Spudding Date _____

Drlg. Data _____

RU

J. G. MCGHEE

Kansas

Map No. _____ Sec. 24 Twp. 24 R. 33W

Well No. 1 State Refuge

Northern Pump Company

CORRECTION Contractor

C SE/4

SECTION PLAT

_____ Ft. from N. Line
1320 Ft. from S. Line
1320 Ft. from E. Line
_____ Ft. from W. Line

Finney County

Location _____

Rig up _____

Drilling and Remarks:

Reported
24-24-34W

RECORD

Cased _____ in., _____ ft.
Sand _____
Gas _____
Oil _____
Total Depth _____

PRODUCTION

1st 24 hrs. Nat. _____
1st 24 hrs. after shot _____
Gas _____ Cu. Ft.
Dry Hole _____
Abandoned _____

Date

JUN 14 1982 19

J. G. McGEHEE

Scout


County Finney State Kansas

Sec. 24 (Blk. 24) (Sur. 33W) (Rge.) Map No.

Operator Northern Pump

Well No. 1 Farm State Refuge

Elev. 2864 Location C SE/4

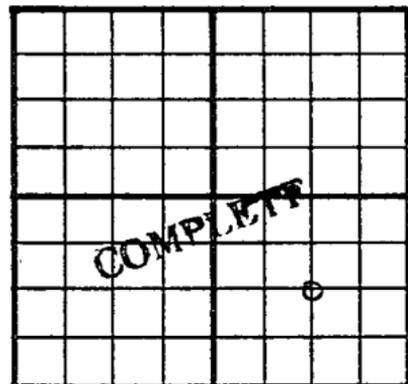

1320 Ft. From S Line SE

1320 Ft. From E Line Quarter

1st. Report

Completion Jul 30 1952

Remarks

Ben Brack - Contr.

Spudding Date 5-28-52

Drilg. Data Gas well TD 2665

10" @ 385 Her. 2534 TD 2665 7" @ 2535

1000 A PB 2645 3200 A Kri. 2558

Win. 2588 Ft. Riley 2650

Comp. 5,433,000 gas 407#