


Section 25 Township 24 Range 5-W

Well Number #1-Mueller

Company L. R. Page et al

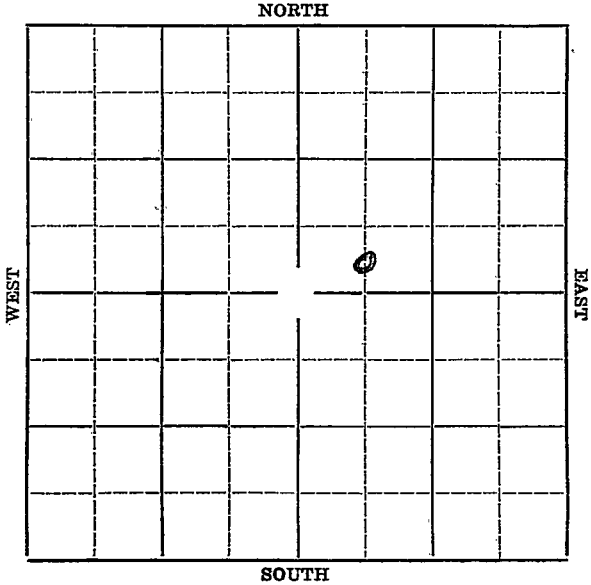

Map No. KANSAS Sec. 25 Twp. 24 R. 5W

Well No. #1 Mueller Farm

L.R. Page et al Company


_____ Ft. from N. Line

330' Ft. from S. Line

_____ Ft. from E. Line

660' Ft. from W. Line

Elev. 1489

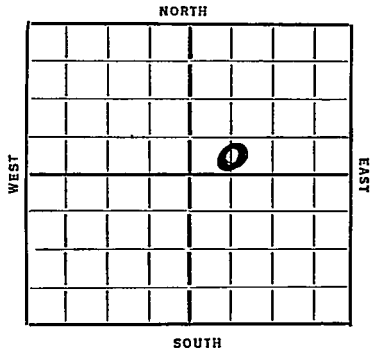

Date	REPORT
1936	
8/12	Rig on ground.
8/20	Rig.
8/27	--
9/3	12" @ 141'. Drlg. 2310'.
9/10	Kansas City 2640'. Chat 3357'. 7" @ 3369'. WOC.
9/18	Drilling 3372'. Show gas.
9/24	Base Mississippi 3580'. Drlg. 3590'
10/1	Miesner 3695'. Hunton 3703'. Show oil 3703-04'. 5" @ 3730'. Drlg. 3731'.
10/7/36	-Viola 3795'. T.D. 3828'. Viola 3795'. Simpson 3817'. Hole full of water 3820'. Dry and abandoned.
	ABANDONED

401110

Revd
 Map No. 40 Sec. 25 Twp. 24 R. 5W

Well No. 1 Mueller

L. R. Page & Co. Company

Contractor

SECTION PLAT

		o	

_____ Ft. from N. Line

330 Ft. from S. Line

_____ Ft. from E. Line

660 Ft. from W. Line

FIRST REPORT

Location _____

Rig up _____

Drilling and Remarks:

ROG

RECORD

Cased _____ in., _____ ft.

Sand _____

Gas _____

Oil _____

Total Depth _____

PRODUCTION

1st 24 hrs. Nat. _____

1st 24 hrs. after shot _____

Gas _____ Cu. Ft.

Dry Hole _____

Abandoned _____

Date

AUG 12 1936 19

S. J. LEWIS Scout

Map No. 40 Sec. 25 Twp. 24 R. 5W

Well No. 1 Mueller

L. R. Page & Co. Company

Contractor

SECTION PLAT

		0	

Ft. from N. Line

330 Ft. from S. Line

Ft. from E. Line

660 Ft. from W. Line

ABANDONED

Location _____

Rig up _____

Drilling and Remarks:

Vista 3795
Superior 3817
NFW 3820
D & H

RECORD

Cased _____ in., _____ ft.

Sand _____

Gas _____

Oil _____

Total Depth 3828

PRODUCTION

1st 24 hrs. Nat. _____

1st 24 hrs. after shot _____

Gas _____ Cu. Ft.

Dry Hole _____

Abandoned _____

Date

OCT 7 1936 19

S. J. LEWIS Scout