


Reno **KANSAS**

Section 25 Township 24 Range 8-W

Well Number 2 Evans

Company Duwe Duston

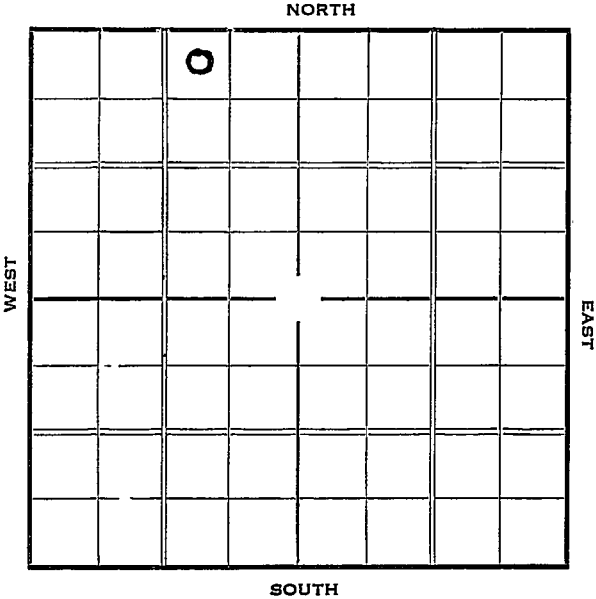

1937

6/9

5" @ 3524'.

Pay 3533-40'.

T.D. 3549'.

2000 acid.

Pot. 316 bbls.

COMPLETED

KANSAS*Perm*Map No. 41 Sec. 25 Twp. 24 R. 8WWell No. 2. Evans.Dawson Dutton Company

Contractor

SECTION PLAT

	0		

330 Ft. from N. Line

_____ Ft. from S. Line

990 Ft. from E. Line

_____ Ft. from W. Line

FIRST REPORT

Location _____

Rig up _____

Drilling and Remarks:

*Good***RECORD**

Cased _____ in., _____ ft.

Sand _____

Gas _____

Oil _____

Total Depth _____

PRODUCTION

1st 24 hrs. Nat. _____

1st 24 hrs. after shot _____

Gas _____ Cu. Ft.

Dry Hole _____

Abandoned _____

Date

APR 7 1937 19

S. J. LEWIS Scout

Reno KANSAS

Map No. 41 Sec. 25 Twp. 24 R. 8^WWell No. 2 - EvansDewee & Austin Company

Contractor

COMPLETED

SECTION PLAT

	0		

330 Ft. from N. Line

_____ Ft. from S. Line

990 Ft. from E. Line

_____ Ft. from W. Line

Location _____

Rig up _____

Drilling and Remarks:

2000 AcidPot 316

RECORD

Cased 5 in. 3524 ft.~~Sand~~ Pay 3533-40

Gas _____

Oil _____

Total Depth 3549

PRODUCTION

1st 24 hrs. Nat. _____

1st 24 hrs. after shot _____

Gas _____ Cu. Ft.

Dry Hole _____

Abandoned _____

Date

JUN 9 1937 19

H. D. Hatfield

Scout