

Stafford


KANSAS

SECTION 25 TOWNSHIP 24 RANGE 12 W

WELL NO. #1 Kissling

COMPANY W. L. Hartman

NORTH

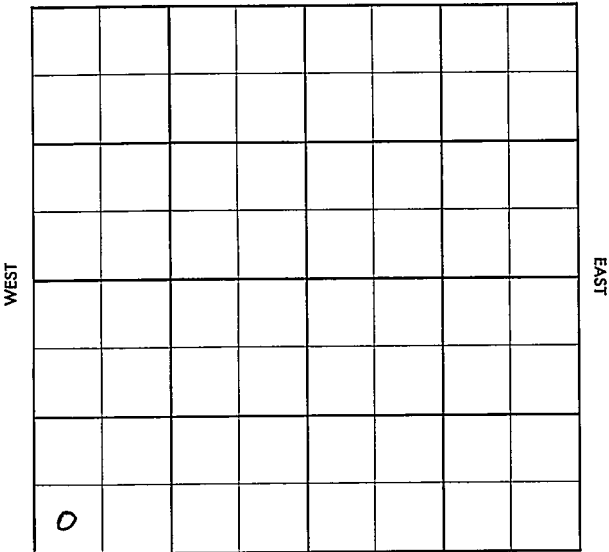

SOUTH

County Stafford Elev. _____
 Sec. 25 Twp. 24 Rge. 12W
 Company W. J. Hartman
 Farm Name Kissling No. 1

TOPS	DEPTH	LOG	DATUM	Loc. in Sec.
Anh.				SW SW SW
Tp.				
H.				
Tr.				
Dg.				
BL.				
L.				Geol. _____
K.C.				Contr. _____
B.K.C.				
Ce.				<u>G.M.R</u>
C.				Pool _____
M.				<u>Wildcat</u>
M.				
K.				
Mz.				
Ma.				
V.				
S.				
S.				
A.				
R.				
PE.				
G.				
T.D.				

FIRST REPORT
 OCT 19 1955

Date Comm. 10-15-55 Skelly - DHM
 8th @ 222/175 drlg. 1973

Co.
 L.se.
 No.
 Sec.
 T.
 R.

[Handwritten signature]

County Stafford Elev. 1852
 Sec. 25 Twp. 24 Rge. 12W
 Company W. D. Hartman
 FarmName Kissling No. 1

TOPS	DEPTH	LOG	DATUM	Loc. in Sec.
Anh.				
Tp.	<u>3002</u>		<u>1150</u>	SW SWSW
H.	<u>3315</u>		<u>1463</u>	
Tr.				
Dg.				
BL.	<u>3470</u>		<u>1618</u>	
L.	<u>3500</u>		<u>1648</u>	Geol.
K.C.				Contr.
B.K.C.				
Ce.				
C.	<u>3837</u>		<u>1985</u>	G-M-R
M.				
M.				Pool
K.	<u>3888</u>		<u>2036</u>	Wildcat
Mz.				
Mq.				
V.	<u>3921</u>		<u>2069</u>	
S.	<u>4028</u>		<u>2176</u>	
S.				
A.	<u>4098</u>		<u>2246</u>	
R.				
PE.				
G.				
TD.	<u>4150</u>			

ABANDONED

Date Comm. 10-15-55 NOV 2 1955

8" @ 222/175 DST 3502-26 open 1 hr.

rec. 30' mud 0/20" DST 3561-3600

open 1 $\frac{1}{2}$ hr. rec. 405' mcsw 1240/15"

BST 3695-3724 open 1 hr. rec. 225'

msw 1145/15" DST 3732-62 open 40 min.

rec. 12' mud Off

D & A