


KANSAS

Stafford

Section 25 Township 24 Range 13-W

Well No. #1 Henderson

Company Aladdin Pet
Wildcat

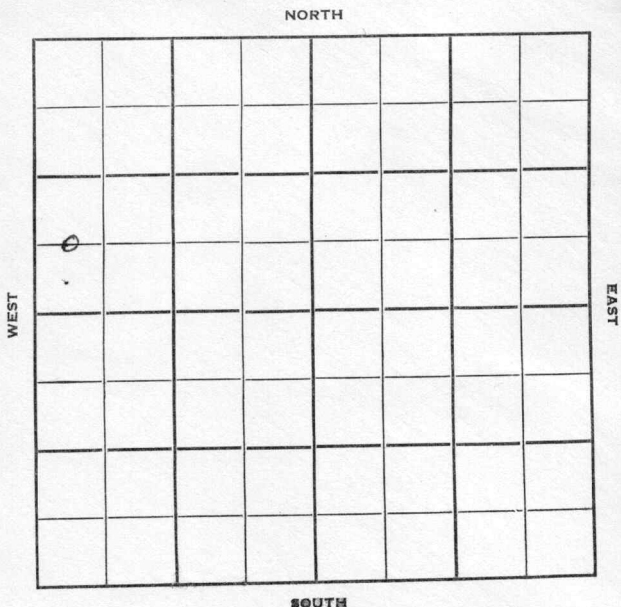

KANSAS Stafford

Sec. 25 Twp. 24 R. 13W

Well No. #1 Henderson Farm
Aladdin Pet. Company

Wildcat (Hannum Drler. ^{NORTH} Contr.)


 Ft. from N. Line

660' Ft. from S. Line

 Ft. from E. Line

330' Ft. from W. Line

C W L SW NW

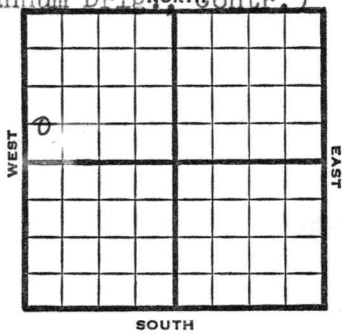

1949 Elev 1912' REPORT

11/30 RUR
12/7 8"@ 452'
12/14 Drlg. 3466'
12/21 TD 4240'
Lansing 3594'
Viola 4044'
Simp 4119'
Arb. 4213'
Aband.

ABANDONED

Map No. _____ Sec. 25 Twp. 24 R. 13W


Well No. 1 Henderson

Aladdin Pet. _____ Company

Hannum Drlg. _____ Contractor

C W L SW NW

FIRST REPORT
SECTION PLAT

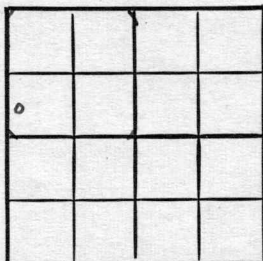

_____ Ft. from N. Line

660 Ft. from S. Line

_____ Ft. from E. Line

330 Ft. from W. Line

Stafford County

Location _____

Rig up _____

Drilling and Remarks:

R UR

RECORD

Cased _____ in., _____ ft.

Sand _____

Gas _____

Oil _____

Total Depth _____

PRODUCTION

1st 24 hrs. Nat. _____

1st 24 hrs. after shot _____

Gas _____ Cu. Ft.

Dry Hole _____

Abandoned _____

Date

NOV 30 1949

19

S. J. LEWIS

Scout

Map No. _____ Sec. 25 Twp. 24 R. 13W

Well No. 1 Henderson

Aladdin Pet.

Company _____


ABANDONED

Contractor _____

C W L S W N W

E1.1912

SECTION PLAT

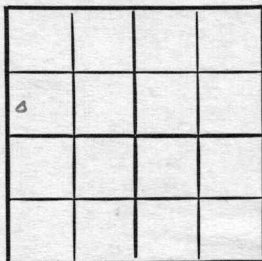

_____ Ft. from N. Line

660 Ft. from S. Line

_____ Ft. from E. Line

330 Ft. from W. Line

Stafford County

Location _____

Rig up _____

Drilling and Remarks:





RECORD

Cased _____ in., _____ ft.

Sand _____

Gas _____

Oil _____

Total Depth 4240

PRODUCTION

1st 24 hrs. Nat. _____

1st 24 hrs. after shot _____

Gas _____ Cu. Ft.

Dry Hole _____

Abandoned _____

Date

DEC 21 1949

19

S. J. LEWIS

Scout