


Section 25 Township 24 Range 11W

Well No. 4 Koelsch

Company Hilton Drlg

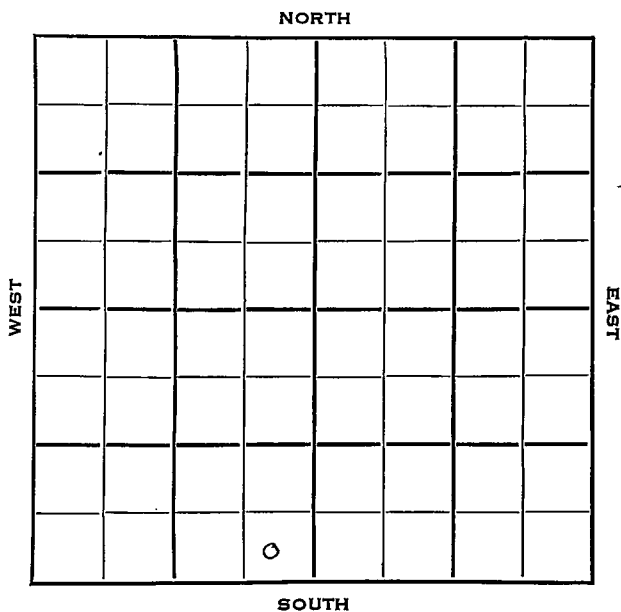

Stafford

KANSAS

25

24

14W

Sec. _____ Twp. _____ R. _____

#4 Koelsch

Well No. _____ Farm _____

Hilton Drlg.

Company _____

Hilton Drlg.

Contractor _____

_____ Ft. from N. Line

NORTH

330


_____ Ft. from S. Line

330

_____ Ft. from E. Line

_____ Ft. from W. Line

SE SE SW

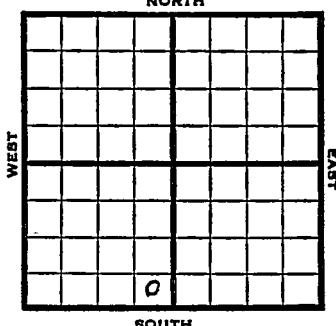

SOUTH

1953

Elev. 1944'

REPORT

4/1

RUR

4/9

8" @ 250

Anhy 830

Drlg. 3100'

4/16

Heeb 3439, Br. L. 3577, Lans 3607

V. 3995

Drlg 4090'

4/23

Simp sho 4131, Simp sd 4139

DST 4130-55 1½ hr. 140' HOCM 220# gas

Arb 4169

RTD 4172

5" @ 4171'

DD 4175 TD FU 3900' oil S/ 22 boph

1200' from top.

4/30

N.R.

5/7

NR

5/13

Spud 3-31-53 Oil well TD 4175

8" @ 250 Anhy 830 Heeb 3439

Br lime 3577 Lans 3607 Viola 3995

Simp sh 4131' Simp. sd 4139'

DST 4130-55 open 1½ hr. rec 140' HOCM

220' gas, 136# Arb. 4169 TD 4172

5" @ 4171 DD 4175 FU 3900' oil

S/22 BOPH Comp. 3000 BOPD

COMPLETED

County Stafford State Kansas

Sec. **25** (Blk. **24** (Sur. **14W** Map No.

Operator **Hilton Delg.**

Well No. 4 Farm Koelsch

Elev.	Location	SE	SE	SW
-------	----------	----	----	----

FIRST REPORT

330Ft. From S Line SW

330 Ft. From E Line Quarter

1st. Report APR 1 1953

Completion

Remarks

Hilton Drlg. - Contr.

Spudding Date

Drlg. Data

R U R

J. G. McGEHEE

County Stafford State Kansas

Sec.	25	(Blk. Twp.)	24	(Sur. Rge.)	14 W	Map No.
------	----	----------------	----	----------------	------	---------

Operator Hilton Drlg.

Well No. 4 Farm Koelsch

Elev.	1944	Location	SE SE SW
-------	------	----------	----------

COMPLETE

0

330 Ft. From S Line SW

330 Ft. From E Line Quarter

1st. Report

Completion MAY 13 1953

Remarks

Hilton Drlg. - Contr.

Spudding Date 3-31-53

Drlg. Data Oil well TD 4175

8" @ 250 Anhy 830 Heeb. 3439

Br. lime 3577 Lans. 3607 Viola 3995

Simp. sch. 4131 Simp. sd. 4139

DST 4130-55 open $1\frac{1}{2}$ hr. Rec. 140' hocrn

220' gas 136# Arb. 4169 TD 4172

5" @ 4171 DD 4175 FU 3900' oil

S/ 22 boph Comp. 3000 bopd

~~J. G. McGEHEE~~

O. W. P. B.

FORM 513 SUNRAY

County Stafford Elev. 1944
 Sec. 25 Twp. 24 Rge. 14W
 Company Hilton Drlg.
 FarmName Koelsch No. 4

TOPS	DEPTH	LOG	DATUM
------	-------	-----	-------

Anh.			
TP.			
H.			
Tr.			
Dg.			
BL.			
L.	3607		
K.C.			
B.K.C.			
Ce.			
C.			
M.			
M.			
K.			
Mz.			
Mq.			
V.	3995		
S. sh.	4131		
S. sd.	4139		
A.	4169		
R.			
PE.			
G.			
T.D.			

Loc. in Sec.

SE SE SW

OWPB

Geol.

Contr.

Pool

SE Koelsch

FIRST REPORT	
JAN 23 '57	
0	

Date Comm.

OTD 4175 5" @ 4171 P/ 72 bo

OO 4173 B/ 16 go $\frac{1}{2}$ gwph P/ 6.67 bo

95% wtr. 6 hr. 42/ 4141-48

FU 8 bo 11 hr. frac P/ 15 bo 24 hr.

13

Co.

County Starford Elev. 1944
 Sec. 25 Twp. 24 Rge. 14W
 Company Hilton Dril.
 Farm Name Koelsch No. 1

TOPS	DEPTH	LOG	DATUM	Loc. in Sec.
Anh.				SE SW
Tr.				ONPB
H.				
Tr.				
Dg.				
Bl.				
L.	3507			Geol.
K.C.				Contr.
B.K.C.				
Ce.				
C.				
M.				
M.				Pool
K.				SE Koelsch
Mz.				
Ma.				
V.	3995			
S. sh.	1131			
S. sd.	1139			
A.	1169			
R.				
Pe.				
G.				
TD.				

Lsc.

No.

Sec.

T.

R.

Date Comm.

OTD 4175 5^u @ 4171 P/ 72 bo

OO 4173 B/ 16 to 1/2 gwnh P/ 6.67 bo

95% wtr. 6 hr. 42/ 4141-18

FU 8 bo 11 hr. frac P/ 45 bo 24 hr.

JAN 30 '57 complete.