


Section 25 Township 24 Range 11W

Well No. #1 Abbott

Company Shell Oil

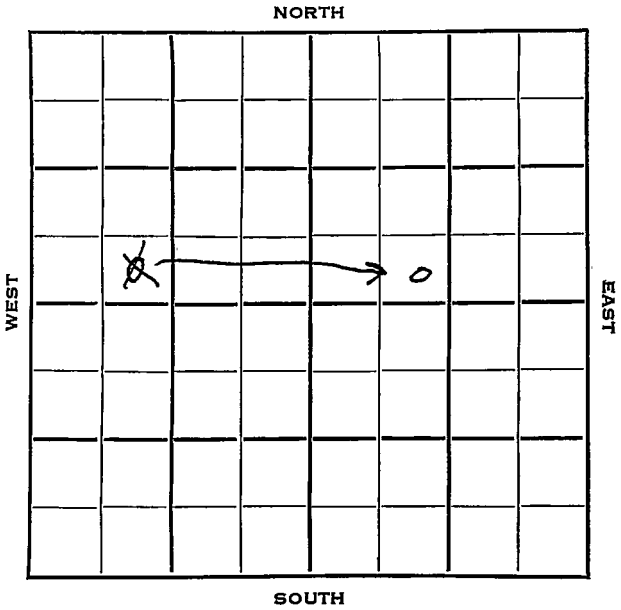

Sec. 25 Twp. 24 R. 14W

Well No. #1 Abbott Farm

Shell Oil Company

Trans-Era Contractor

Koelsh Pool


Ft. from N. Line

330 Ft. from S. Line

Ft. from E. Line

990 Ft. from W. Line

~~SE SW NE~~  
~~SE SW NW~~

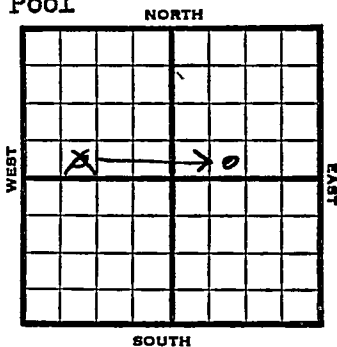

1953 Elev. 1941' REPORT

7/22 Spud 7-20-53

Fsg @ 215'

7/29 8" @ 832 w/575

Anhy 825' Drlg. 3025'

8/5 Land 3595'

Drlg 4083'

8/12 Marm 3864, V. 4000, Simp 4123, Arb 4174

RTD 4176

Schl. 5" @ 4175'

DD 4186

TD

FU 3600' oil 2 hrs, S/ 4/4 BOPH 4 Hrs.

8/19 Spud 7-20-53

Oil Well

TD 4186'

8" @ 832

Anhy 825, Heeb 3430, Lans 3595,

Marm 3864, Viola 4000', Simp 4133,

Arb. 4174

TD 4176

5" @ 4175

DD 4186, FU 3600' oil 2 hrs.

S/4/4 boph 4 hrs.

Comp. 3000 bopd

COMPLETED


County Stafford State Kansas

Sec. 25 (Blk.) 2A (Sur.) 14W Map No.

Operator Shell Oil

Well No. 1 Farm Abbott

Elev. \_\_\_\_\_ Location SE SWNW

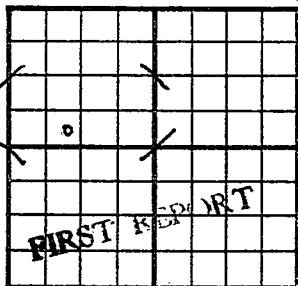

330 Ft. From S Line NW

990 Ft. From W Line Quarter

Ist. Report JUL 22 1953

Completion \_\_\_\_\_

Remarks Arb. test

Trans-Era - Contr.

Spudding Date 7-20-53

Drlg. Data Koolish Pool

fsg @ 215

KANDAR

Map No. \_\_\_\_\_ Sec. 25 Twp. 24 R. 14W

Well No. 1 Abbott

Shell Oil Company

CORRECTION Contractor

SE SW NE


SECTION PLAT

\_\_\_\_\_ Ft. from N. Line

330 Ft. from S. Line

\_\_\_\_\_ Ft. from E. Line

990 Ft. from W. Line

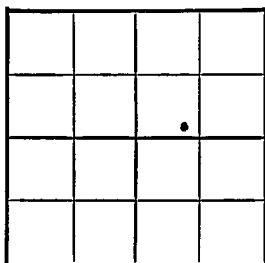

Stafford County

Location \_\_\_\_\_

Rig up \_\_\_\_\_

Drilling and Remarks:

Reported  
SE SWNW

RECORD

Cased \_\_\_\_\_ in., \_\_\_\_\_ ft.

Sand \_\_\_\_\_

Gas \_\_\_\_\_

Oil \_\_\_\_\_

Total Depth \_\_\_\_\_

PRODUCTION

1st 24 hrs. Nat. \_\_\_\_\_

1st 24 hrs. after shot \_\_\_\_\_

Gas \_\_\_\_\_ Cu. Ft.

Dry Hole \_\_\_\_\_

Abandoned \_\_\_\_\_

Date

JUL 29 1953

19

J. G. McGEHEE

Scout


County Stafford State Kansas

Sec. 25 (Blk. Twp.) 24 (Sur. Rge.) 14W Map No.

Operator Shell Oil

Well No. 1 Farm Abbott

Elev. 1941 Location SE SW NE

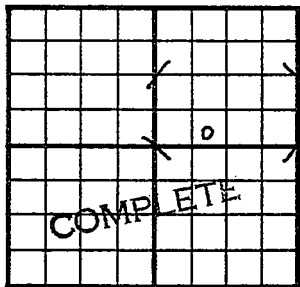

330 Ft. From S Line NE

990ft. From W Line Quarter

1st. Report

Completion AUG 10 1953

Remarks Koelsch Pool

Trans-Era - Contr.

Spudding Date 7-20-53

Drlg. Data Oil well TD 4186

8" @ 832 Anhy 825 Heeb. 3430

Lans. 3595 Marm. 3864 Viola 4000

Simp. 4133 Arb. 4174 TD 4176

5" @ 4175 DD 4186 FU 3600' oil 2 hr.

S/ 44 boph 4 hr. Comp. 3000 bopd