


Section 25 Township 24 Range 11W

Well No. 2 Abbott

Company Shell Oil

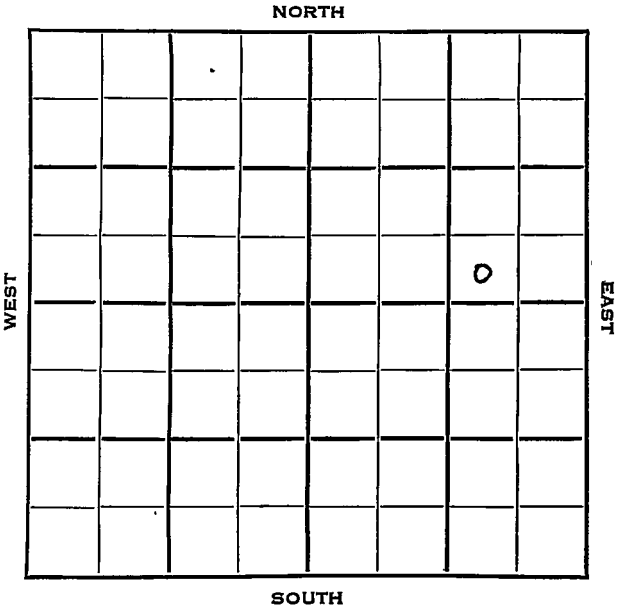

Stafford KANSAS

SEC. 25	TWP. 24	R. 14 W
---	---	---

WELL NO.

2 Abbott

FARM

COMPANY

Shell Oil

CONTRACTOR

Trans-Era


_____ Ft. from N. Line

330 _____ Ft. from S. Line

990 _____ Ft. from E. Line

_____ Ft. from W. Line


SW SE NE

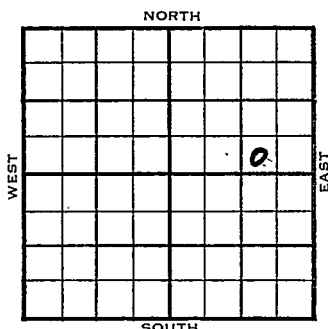

	ELEVATION	REPORT
1953	1941'	
11/4	Spud 11-1-53 8" @ 830 WOC	
11/11	Anhy 825' Drig 3670'	
11/18	Lans 3603', V 4014', Arb 4187' RTD 4189' 5" @ 4188' w/175 sks.	
12/2	Spud 11-1-53 Oil well TD 4194 8" @ 830 Anhy 825' Lans 3603 Viola 4014 Arb. 4187 TD 4189 5" @ 4188 DD 4194 FU 800' oil 1 hr. S/22½ BOPH 6 hr. 2000 A S/58½ BOPH 4 hr. Schl. tops: Heeb 3437' Tor. 3458' Br lime 3576 Lans 3602' Marm 3873 Kh. 3961 Viola 4021 Simp. 4139 Arb. 4189' Comp. 3000 BOPD	

COMPLETED

County Stafford State Kansas
 Sec. 25 (Blk.) 24 (Sur.) 14W Map No.
 Operator Shell Oil
 Well No. 2 Farm Abbott
 Elev. _____ Location SW SE NE

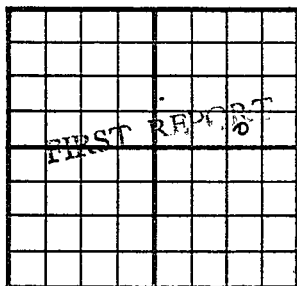

330 Ft. From S Line NE
990 Ft. From E Line Quarter
 Ist. Report NOV 4 1953
 Completion _____
 Remarks _____
Trans-Era - Contr.
 Spudding Date 11-1-53

Drlg. Data

8" @ 830 WOC


J. G. McGEHEE

County Stafford State Kansas
 Sec. 25 (Blk. 24) (Sur. 14W) Map No.

Operator Shell Oil

Well No. 2 Farm Abbott

Elev. 1941 Location SW SE NE

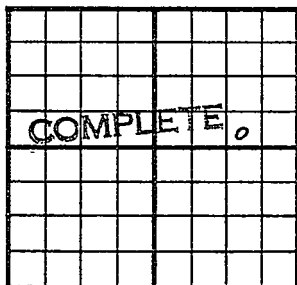

330 Ft. From S Line NE

990 Ft. From E Line Quarter

Ist. Report

Completion DEC 2 1953

Remarks

Trans-Era - Contr.

Spudding Date 11-1-53

Drlg. Data Oil well TD 4194

8" @ 830 Anhy 825 Lens. 3603

Viola 4014 Arb. 4187 TD 4189

5" @ 4188 DD 4194 FU 800' oil 1 hr.

S/ 22½ boph 6 hr. 2000 A S/ 58½ boph

4 hr. SCHLUMBERGER TOPS:

Heeb. 3437 Tor. 3458 Br. lime 3576

Lens. 3602 Marm. 3873 Kh. 3961

Viola 4021 Simp. 4139 Arb. 4189

Comp. 3000 bopd

J. G. MCGEHEE