

Section 25 Township 24 Range 14W

Well No. 3. Abbott

Company Helmerich & Payne

NORTH

WEST

EAST

SOUTH

Stafford


Sec. 25 Twp. 24 R. KANSAS 14WWell No. #3 Abbott FarmHelmerich & Payne CompanyWendell Peel - Contr. Contractor990 Ft. from N. Line

Ft. from S. Line

Ft. from E. Line

990 Ft. from W. Line

SE NW NW

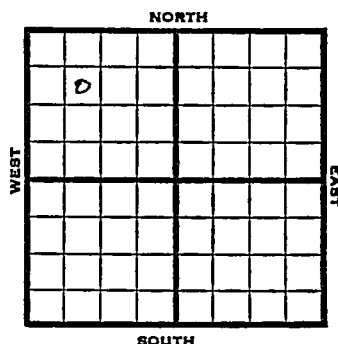

1953 Elev. 1947' REPORT

3/4 R U R
 3/12 8" @ 840
 Anhy 844
 Drlg.
 3/19 Heeb 3463, Br li 3598, Lans
 3625
 DST 3748-64, 1 hr., 330' oil,
 50' O&GCM, 1045#
 RTD 3900 Schl
 3/26 5" @ 3785½' CO 3764 30/3752-59
 1 BOPH 2000 A F/19-3/4 BOPH
 4/2 NR
 4/8 Spud 3-4-53 Oil well TD 3900
 8" @ 848 Anhy 844 Heeb 3463
 Br lime 3598 Lans 3625
 DST 3748-64 open 1 hr. rec 330' oil
 50' O & GCM 1045# TD 3900
 5" @ 3785½' CO to 3764
 30/3752-59 1 BOPH 2000 A
 F/19 - 3/4 BOPH
 Comp. 179 BOPD 1% wtr.

COMPLETED

County Stafford State Kansas

Sec. **25** (Blk. **24** (Sur. **147** Map No.

Operator **Helmerich & Payne**

Well No. **3** Farm **Abbott**

Elev.	Location	SE	NW	NW
-------	----------	----	----	----

0

FIRST REPORT

990 Ft. From N Line NW

990 Ft. From W Line Quarter

1st. Report MAR 4 1953

Completion

Remarks

Wendell Peel - Contr.


Spudding Date

Drlg. Data

R U R

J. G. McGENEE

County Stafford State Kansas
 Sec. 25 (Blk. 24) (Sur. 14W) (Rge.) Map No.
 Operator Helmerich & Payne
 Well No. 3 Farm Abbott
 Elev. 1947 Location SE NW NW

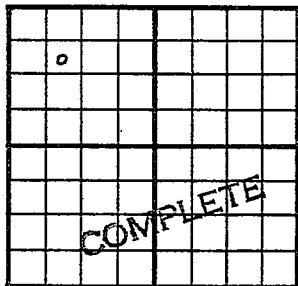

990 Ft. From N Line NW
990 Ft. From W Line Quarter

1st. Report

Completion APR 8 1953

Remarks

Wendell Peel - Contr.

Spudding Date 3-4-53

Drilg. Data Oil well TD 3900

8" @ 848 Anhy 844 Heeb. 3463

Br. lime 3598 Lans. 3625 DST 3748-64

open 1 hr. Rec. 330' oil 50' o & gcm

1045# TD 3900 5" @ 3785 $\frac{1}{2}$ CO to 3764

30/ 3752-59 1 boph 2000 A F/ 19 3/4 bop

Comp. 179 bopd 1% wtr.

J. G. McGEHEE