

Section 25 Township 24 Range 11 WWell No. # 1 Abbott "A"Company Helmerich & Payne

						0	

NORTH

WEST

EAST

SOUTH

INSAS

Sec. 25 Twp. 24 R. 14W

Well No. #1 Abbott "A" Farm

Helmerich & Payne

Company

Hilton Drlg.

Contractor

~~Koelsch Pool~~

990

Ft. from N. Line


Ft. from S. Line

990

Ft. from E. Line

Ft. from W. Line

SW NE NE

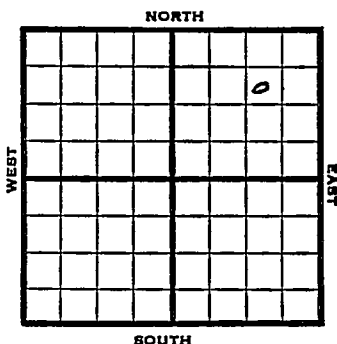

1953

Elev. 1937' REPORT

REPORT

7/22

M I R

7/29

8" @ 250 Anhy 828
Drlg. 3000'

Drlg. 3000:

8/5

Heeb 3454, Lans 3624
Drlg 4074'

Drlg 4074'

8/12

Spud 7-22-53

D & A

TD 4243

8" @ 250'

Anhy 828, Heeb 3454, Ians 3624, Br.
Lime 3591

Time 3591

DST 3689-3702 opn 1 hr, rec 165' sw
1220#

Cong 3938, Viola 4034, Simp 4184,
Arb 4222

TD 4243'

D & A

ABANDONED

County Stafford State Kansas

Sec. 25 (Blk.) 24 (Sur.) 14W Map No.

Operator **Helmerich & Payne**

Well No. **1** Farm **Abbott "A"**

Elev.	Location	SW	NE	NE
-------	----------	----	----	----

FIRST REPORT

990 Ft. From N Line NE

990 Ft. From E Line Quarter

1st. Report 106.3 2 1953

Completion

Remarks

Hilton Drlg. - Contr.

Spudding Date _____

Drig. Data Koelsch Pool

MIR

County	Stafford	State	Kansas
Sec.	25 (Blk. Twp.)	24 (Sur. Rge.)	14W Map No.
Operator	Heimerich & Payne		
Well No.	1	Farm	Abbott "A"
Elev.	1937	Location	SW NE NE

0

ABANDONED

990 Ft. From N Line NE

990 Ft. From E Line Quarter

1st. Report

Completion **AUG 12 1953**

Remarks Koelsch Pool

Hilton Drlg. - Contr.

Spudding Date 7-22-53

Drbg. Data D & A TD 4243

8" @ 250 Anhv 828 Heeb. 3454

Lans. 3624 Br. lime 3591 DST 3689-3702

open 1 hr. Rec. 165' sw 1220#

Cong. 3938 Viola 4034 Simp. 4184

Arb. 4222 TD 4243

D & A