


FORM 51 **Stafford**

KANSAS

Section 25 Township 24 Range 14W

Well No. 3 Koelsch

Company Hilton Drlg.

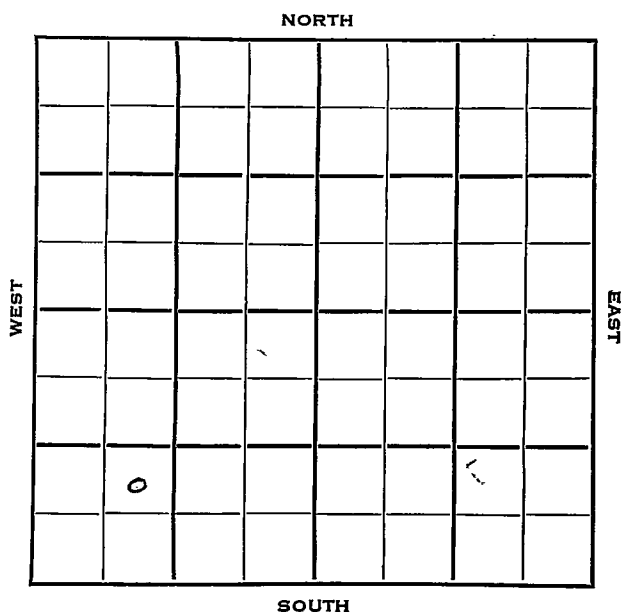

Stafford


KANSAS ✓

Sec. 25 Twp. 24 R. 11WWell No. 3 Koelsch FarmHilton Drlg. CompanyHilton Drlg. Contractor Ft. from N. Line

990

 Ft. from S. Line Ft. from E. Line

990

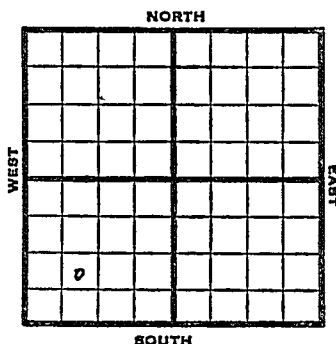 Ft. from W. LineNE S^W SW

1953

Elev. 1947'

REPORT

1/7

Spudding Date 12/31/52

8" @ 250 Anhy 835 Drlg. 1830

1/22

Drlg.

1/28

Spud 12-31-52 D & A TD 4263'

8" @ 250 Anhy 835' Heeb 3449'

Doug. 3516' Br. lime 3613'

Lans. 3640'

DST 3892-3910 open $\frac{1}{2}$ hr. rec 10' mud

O# Cong. 3963' Kh. 3975'

Viola 4049'

DST 4042-66 open $1\frac{1}{2}$ hr. rec 30' mud O#

Simp. sh. 4199' Simp. sd. 4204'

DST 4202-29 open 1 hr. rec 320' SW 1350#

Arb. 4238' TD 4263'

D & A

ABANDONED

J. G. McGEHEE