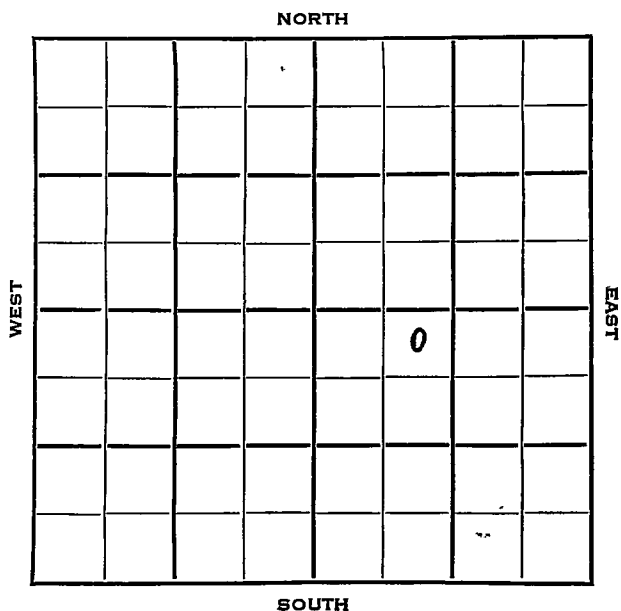


Section 25 Township 24 Range 14 WWell No. # 2 PrescottCompany Shell Oil

Stafford

KANSAS

Sec. 25 Twp. 24 R. 14 W

Well No. # 2 Prescott Farm

Shell Oil.

Company

K & E Drlg.

Contractor

SE Koelsch Pool

330

_Ft. from N. Line


_Ft. from S. Line

Ft. from E. Line

990

_Ft. from W. Line

NE NW SE

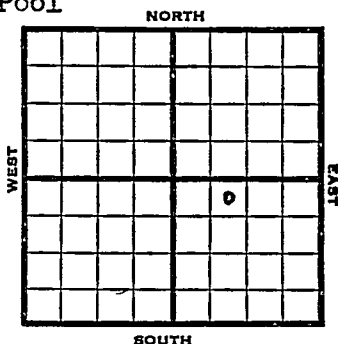

1953

Elev. 1943' REPORT

6/24

Spud 6-16-53

811 @ 832

Drlg. 3165!

7/1

Lans 3591

Drlg. 4075:

7/8

Marm 3856 Cong 3907 KH 3927

V 3986 Simp 4113 Arb. 4157

RTD 4231 5th @ 4229 Schl

5" @ 4229 CO 4210'

7/22

Spud 6-16-53

Oil Well

TD 4231:

8th @ 832:

Lans 3591, Marm 3856, Cong 3907, Kh

3927, Viola 3986, Simp 4113, Arb

4157

TD 4231

5" @ 4229'

CO to 4210 24/ 4192-98 66 boph 3

hr. 120/ 4152-82 S/ 46 boph


4 hr.

P/ 221 bo 22 hr.

Comp. 2523 bopd 11% wtr.

COMPLETED

J. G. McGEHEE

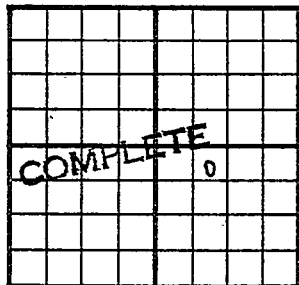County Stafford State KansasSec. 25 (Blk.) 24 (Sur.) 14W Map No.Operator Shell OilWell No. 2 Farm PrescottElev. 1943 Location NE NW SE330 Ft. From N Line SE990 Ft. From W Line Quarter

1st. Report

Completion JUL 22 1953Remarks SE Koelsch PoolK & E Drlg. - Contr.Spudding Date 6-16-53Drlg. Data Oil well TD 42318" @ 832 Lans. 3591 Marm. 3856Cong. 3907 Kh. 3927 Viola 3986Simp. 4113 Arb. 4157 TD 42315" @ 4229 CO to 4210 24/ 4192-9866 boph 3 hr. 120/ 4152-82 S/ 46 boph4 hr. P/221 bo 22 hr.Comp. 2523 bopd 11% wtr.

J. G. McGEHEE