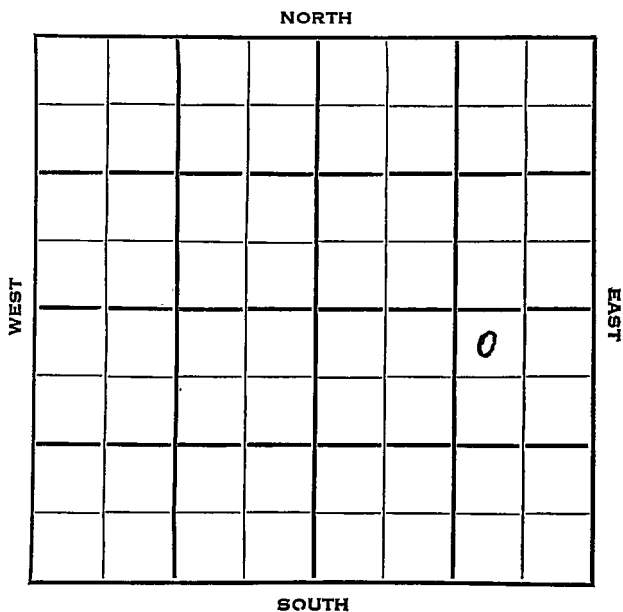


Section 25 Township 24 Range 14 WWell No. # 3 PrescottCompany Shell Oil

Stafford

KANSAS

SEC.	TWP.	R.
25.	24	14W

WELL NO.

3 Prescott

FARM

COMPANY

Shell Oil

CONTRACTOR

Trans-Era

SE Koelsch Pool

330

Ft. from N. Line


Ft. from S. Line

990

Ft. from E. Line

Ft. from W. Line

NW NE SE

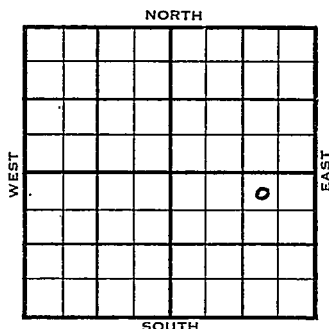

1953

ELEVATION

Elev. 1939'

REPORT

10/21

Spud 10-16-53

8" @ 822'

Drlg. 2047'

10/28

Drlg 3975'

11/4

Lans 3601, Arb 4175,

RTD 4177'

5" @ 4177' Schl

DD 4180'

FU 600' fluid 1½ hrs.

11/11

DD 4182'

1000 A S/ 9 boph / trace 4 hrs.

DD 4187' TD

S/ 27 boph 1500' OB 9 hrs. 1000 A

S/ 31 boph 7 hrs. 1500' O.B. POP.

11/18

Spud 10-16-53 Oil well TD 4187

8" @ 822' Lans 3601 Arb. 4175

TD 4177 5" @ 4177 DD 4180

FU 600' fluid 1½ hr. DD 4182 1000 A

S/9 BOPH 4 hr. DD 4187 S/27 BOPH

1000 A S/31 BOPH 7 hr.

Comp. 1467 BOPD

COMPLETED

~~8^B @ 822 drlc. 2047~~

