


Section 25 Township 24 Range 14W
Well No. 1 - Tregallis (Tregellas)
Company Shell Oil

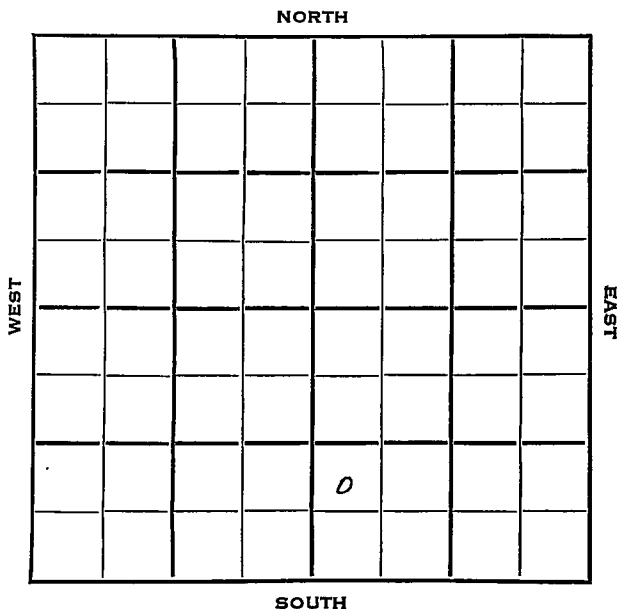

Stafford

FORM 252-B

KANSAS ✓

Sec. 25 Twp. 24 R. 14W

Well No. 1 Tregallis Farm

Shell Oil Company

K & E Drlg. Contractor

Ft. from N. Line

990


Ft. from S. Line

Ft. from E. Line

330

Ft. from W. Line

NW SW SE

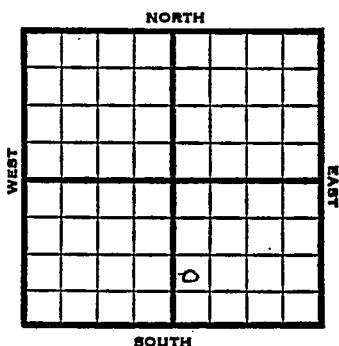

1952 Elev. 1940' REPORT

12/30 Cellar & Pits

1/1 C&P

1/8 Ø510

1/22 Lans 3594, Marm 3840, Cong
3895, KH 3929, V 3981
Drlg. 4 105'1/29 Simp 4130' Arb. 4167'
RTD 4237' 5" @ 4237' sch1 CO 4202'2/5 40/4190-98, S/7' boph 6 hrs.
40/4180-90,
FU 800' oil, no wtr.,
40/4170-80, 40/4160-70
S/30 BOPH, S/153 BO 3 hrs. 500A
P/90 BO 6 hrs.

2/12 NR

2/19 "

2/26 N.R.

OVER

#1Tregallis

1953

3/4

Spud 1-6-53

OilWell

TD 4237

8" @ 829

Anhy 829, Lans 3594, Marm

3840, Cong 3895, Kh 3929,

Viola 3981, Simp 4130, Arb.

4167

TD 4237

5" @ 4237

GO to 4202

40/4190-98, S/7 boph 6 hrs.,

40/4180-90, FU 800' oil

40/4170-80, 40/4160-70

S/30 boph S/153 bo 3 hrs.

500A

P/90 bo 6 hrs.

Comp 3000 bopd

COMPLETED

County Stafford State KansasSec. 25 (Blk. Twp.) 24 (Sur. Rge.) 14W Map No.Operator Shell OilWell No. 1 Farm TregallisElev. Location NW SW SE

FIRST REPORT

990Ft. From S Line SE330Ft. From W Line Quarter1st. Report DEC 30 1952

Completion


Remarks

K & E Drlg. - Contr.

Spudding Date

Drlg. Data

Cellar & pits

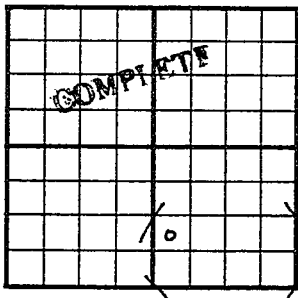County Stafford State KansasSec. 25 (Blk.
Twp.) 24 (Sur.
Rge.) 14W Map No.Operator Shell OilWell No. 1 Farm TregallisElev. 1940 Location NW SW SE990 Ft. From S Line SE330 Ft. From W Line Quarter1st. ReportCompletion MAR 4 1953RemarksK & E Drlg. - Contr.Spudding Date 1-6-53Drlg. Data Oil well TD 42378" @ 829 Anhy 829 Lans. 3594Marm. 3840 Comg. 3895 Kh. 3929Viola 3981-3 Simp. 4130 Arb. 4167TD 4237 5" @ 4237-4237 CO. to 420240/ 4190-98 S/ 7 boph 6 hr. 40/ 4180-90FU 800' oil 40/ 4170-80 40/ 4160-70S/ 30 boph S/ 153 bo 3 hr. 500 AP/ 90 bo 6 hr. Comp. 3000 bopd

J. G. McGEHEE