


Section 25 Township 24 Range 14W
Well No. 1 "W" Tregellas
Company Shell Oil

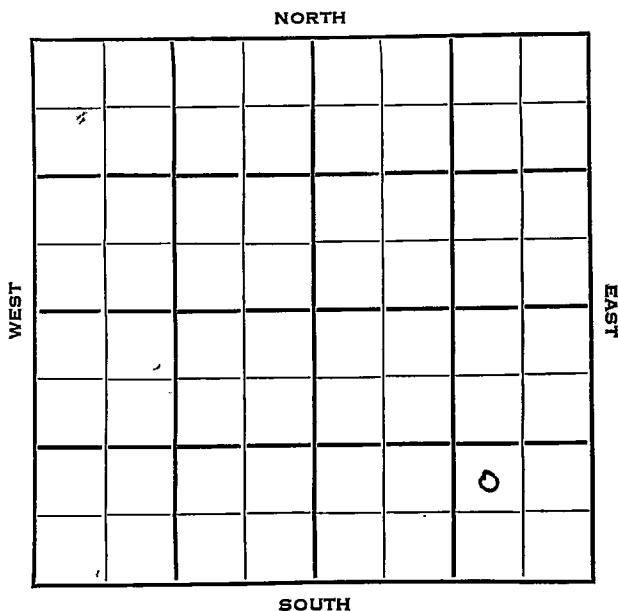

Stafford

KANSAS

SEC.	TWP.	R.
25	24	14W

WELL NO. _____

COMPANY #14W Tregellas FARM

CONTRACTOR Shell Oil

Trans-Era

SE Koelsch Pool

NORTH

WEST EAST

SOUTH

0

NW SE SE

1954	ELEVATION	REPORT
	1942'	

1/6	RURT for SWD
1/13	10" @ 833' Anhy 823' Drlg 2730'
1/20	Drlg 4049'
1/27	Drlg 4715'
3/10	Spud 1-5-54 SWD Well TD 4751' 10" @ 833' Anhy 823', Heeb 3450', Tor 3472', Br lime 3589', Lans 3620', Marm. 3888', Kh. 3979', Arb. 4250' TD 4751' 7" @ 4266' CO to 4751' Comp. for SWD Well

ABANDONED

County Stafford State Kansas

Sec. 25 (Blk. Twp.) 24 (Sur. Rge.) 14W Map No.

Operator Shell Oil

Well No. 1 Farm "W" Tregollas

Elev.	Location	NE	SE	SE
-------	----------	----	----	----

FIRST REPORT

990 Ft. From S Line SE

999 Ft. From 75 Line Quarter

1st. Report JAN 6 1954

Completion

Remarks


Trans-Era - Contr.

Spudding Date:

Drlg. Data **SE Koelsch Pool**

RURT for SWD

J. G. McGENRE

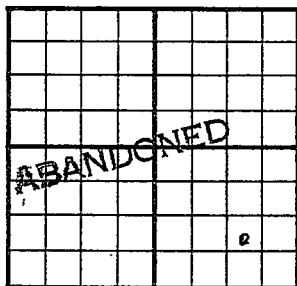County Stafford State KansasSec. 25 (Blk. 24 (Sur. 14W Map No.Operator Shell OilWell No. 1 Farm Tregellas SWDElev. 1942 Location NW SE SE990 Ft. From S Line SE990 Ft. From E Line Quarter

1st. Report

Completion MAR 10 1954Remarks SE Koelsch PoolTrans-Era - Contr.Spudding Date 1-5-54Drlg. Data SWD well TD 475110" @ 833 Anhy 823 Heeb. 3450Tor. 3472 Br. lime 3589 Lans. 3620Marm. 3888 Kh. 3979 Arb. 4250TD 4751 7" @ 4266 CO to 4751Comp. for SWD well