


DX 78-1 Stafford

KANSAS

Section 25 Township 24 Range 15W

Well No. #2 Carpenter

Company Natural Gas & Oil

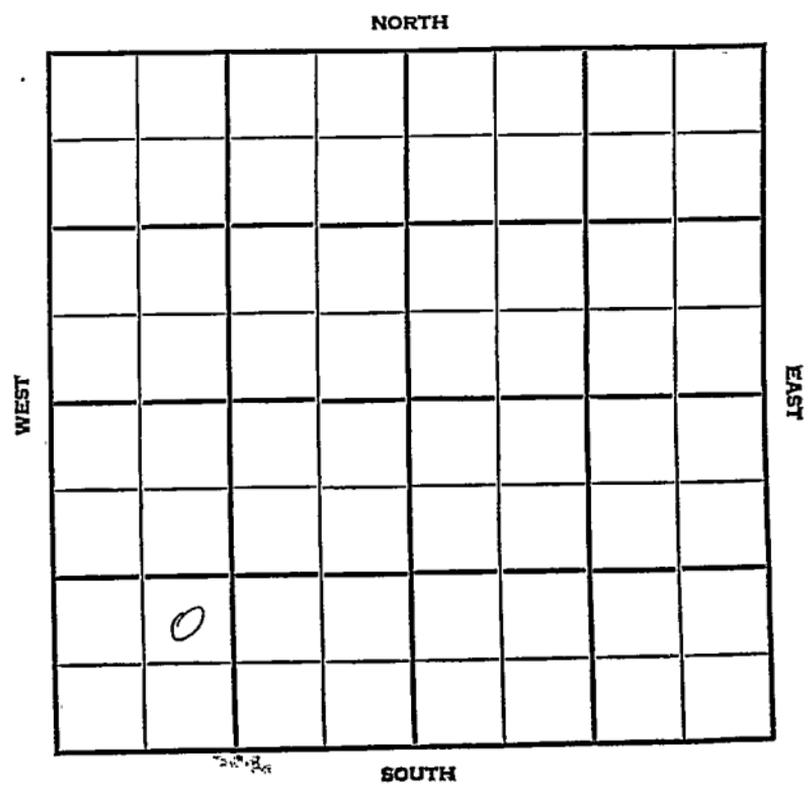



County Stafford Elev. \_\_\_\_\_  
 Sec. 25 Twp. 24 Rge. 15W  
 Company Natural Gas & Oil  
 FarmName Carpenter No. 2

TOPS	DEPTH	LOG	DATUM
Anh.			
Tp.			
H.			
Tr.			
Dg.			
Bl.			
L.			
K.C.			
B.K.C.			
Ce.			
C.			
M.			
M.			
K.			
Mz.			
Mq.			
V.			
S.			
S.			
A.			
R.			
PE.			
G.			
T.D.			

Loc. in Sec. NE SW SW

Geol. \_\_\_\_\_

Contr. Peel Bros.

Pool NE Farmington

FIRST REPORT

MAY 29 56

Date Comm. 5-24-56  
10<sup>th</sup> @ 201/300 delg. 2410

*[Handwritten scribbles and signatures]*

Co.  
Lse.  
No.  
Sec.  
T.  
R.

County Stafford Elev. 2009  
 Sec. 25 Twp. 24 Rge. 15W  
 Company Natural Gas & Oil  
 Farm Name Carpenter No. 2

TOPS	DEPTH	LOG	DATUM	Loc. in Sec.
Anh.				NE SW SN
Tr.				
Dg.				
BL.	<u>3592</u>			
L.	<u>3750</u>			
K.C.				Geol.
B.K.C.	<u>4010</u>			Contr.
Ce.				Peel Bros.
C.				Pool
M.	<u>4122</u>			NE Farmington
M.				
K.				
Mz.				
Ma.				
V.	<u>4187</u>			
S.				
S.				
A.	<u>4414</u>			ABANDONED
R.				
PE.				
G.				
TD.	<u>4464</u>			

Date Comm. 5-24-56

10" @ 201/300 J.L. 2110 JUN "

DST 3871-92 (60) 360 GIP 60'

BHP 120' OCSW FPO, BHP 200(25)

4416 JUN 13 '56 DST 4415-24 11hr

20' W/B BHP 0', DST 4419-25 11hr

WB 11", 10' 50' CM, 70' W/M, BHP 900

in 15" DST 4425-31, 11hr, WB 200'

S.W., F160 - BHP 1500 in 15'

No log D &amp; A