


Section 25 Township 24 Range 16WWell No. #1 ElmoreCompany M. B. Armer Drlg.

NORTH

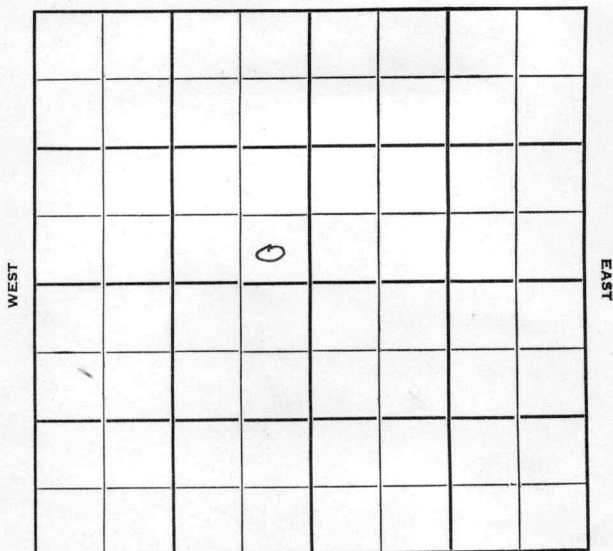

SOUTH

HOT FILE

Edwards

KANSAS ✓

Sec. 25 Twp. 24 R. 16 WWell No. # 1 Elmore FarmM. B. Armer Drlg. Company

Contractor

MCPC has S/2 of 24-24-16W

Wildcat

NORTH

Ft. from N. Line

330 Ft. from S. Line330 Ft. from E. Line

Ft. from W. Line

SE SE NW

Sinclair - DHM

Carter - \$3500.00

WEST

EAST

SOUTH

1952

Elev. 2062'

REPORT

5/21

Spud 5-17-52

8" @ 258' Anhy 880'

Drlg. 2250'

5/28

Heeb. 3663

Br Li 3795

Lans KC 3805

Drlg. 3890'

6/11

Spud 5-17-52

D&A TD 4680

8" @ 258'

Anhy 880

Heeb. 3663

Br Li 3795

Lans. 3805

Miss 4219

Kh. 4252

DST 4265-4355 open 1-3/4" hr.

rec. 40' mud

Viola 4347

Simp. 4540

Arb. 4606 TD 3680' D&A

4680


ABANDONED

4606
2062
2544

4606
2062
2544

2062
450
182
3805
2062
1743
2190

County **Edwards** State **Kansas**
 Sec. **25** (Blk.) **24** (Sur.) **16W** Map No.
 Operator **M. B. Arner Drlg.**
 Well No. **1** Farm **Elmore**
 Elev. Location **SE SE NW**

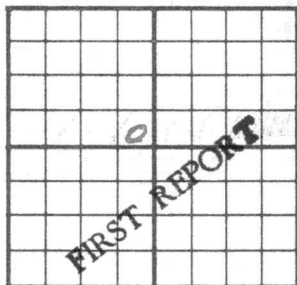

330 Ft. From **S** Line **NW**
330 Ft. From **E** Line Quarter

1st. Report **MAY 21 1952**

Completion

Remarks **Sinclair-IHM**


Carter \$ 3500.

Spudding Date **5-17-52**

Drlg. Data **MCPC has S/2 of 24-24-16W Wildcat**
8" @ 258 Any 880 Drlg. 2250

J. G. McGEHEE

County Edwards State Kansas
 Sec. 25 (Blk. 24 (Sur. 16W Map No.
 Twp.) Rge.)
 Operator M. B. Armer Drlg.
 Well No. 1 Farm Elmore
 Elev. 2062 Location SE SE NW

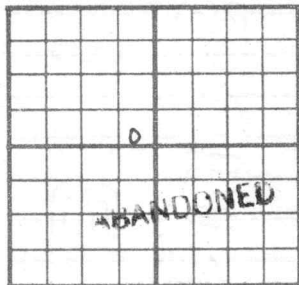

330 Ft. From S Line NW
330 Ft. From E Line Quarter
 1st. Report
 Completion JUN 11 1952
 Remarks Wildcat
 Spudding Date 5-17-52

Drlg. Data D & A TD 4680
8" @ 258 Anhy 880 Heeb. 3663
Br. lime 3795 Lans. 3805 Miss. 4219
Kh. 4252 DST 4265-4355 open 1 3/4 hr.
Rec. 40' mud Viola 4347 Simp. 4540
Arb. 4606 TD 4680

D & A