


SECTION 25 TOWNSHIP 24 RANGE 32W

WELL NO. #1 Morris G.U.

COMPANY Pan American Petr. Co.

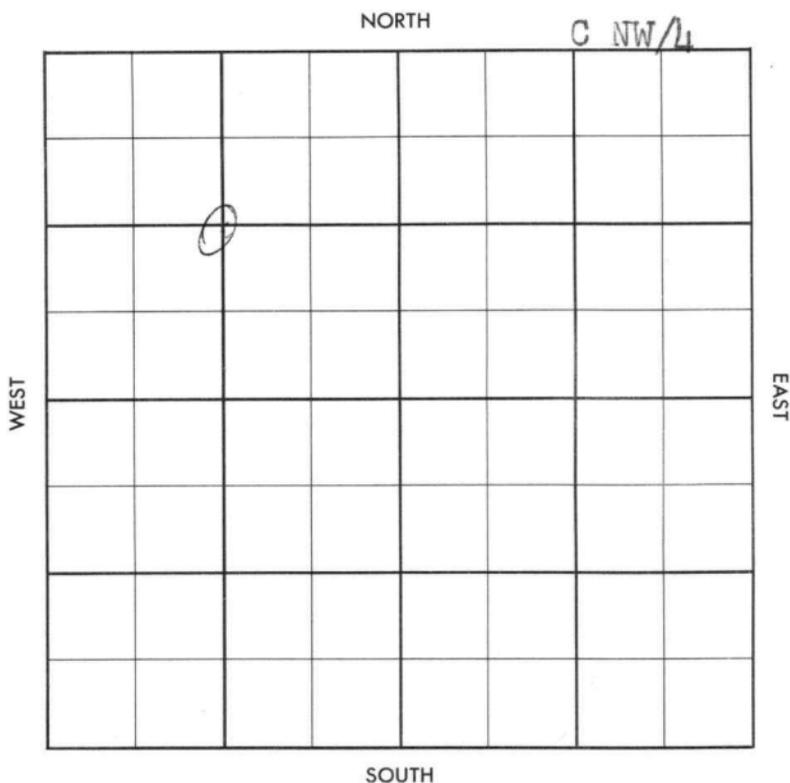

County Firney Elev. _____
 Sec. 25 Twp. 24 Rge. 32W
 Company Pan American Pet. Corp.
 Farm Name Morris G.U. No. 1

TOPS	DEPTH	LOG	DATUM	Loc. in Sec.
Anh.				C NW/4
Tp.				
H.				
Tr.				
Dg.				Geol. _____
Bl.				Contr. _____
L.				Noble Drilg.
K.C.				
B.K.C.				Pool _____
Ce.				Hugoton
C.				
M.				
M.				
K.				
Mz.				
Mo.				
V.				
S.				
S.				
A.				
R.				
PE.				
G.				
T.D.				

Date Comm. _____
 Location, WOOR


35

Co.
Lse.
No.
Sec.
T.
R.

County Finney Elev. 2816 OF
 Sec. 25 Twp. 24 Rge. 32W
 Company Pan American Pet. Corp.
 Farm Name Morris G.U. No. 1

TOPS	DEPTH	LOG	DATUM
Anh. <u>121</u>		<u>2532</u>	
Tp. <u>KFI</u>		<u>2556</u>	
H.			
Tr.			
Dg.			
Bl.			
L.			
K.C.			
B.K.C.			
Ce.			
C.			
M.			
M.			
K.			
Mz.			
Me.			
V.			
S.			
S.			
A.			
R.			
PE.			
G.			
TD.	<u>2589</u>		

Loc. in Sec. C NW/4
 Geol. _____
 Contr. Noble Drlg.
 Pool Hugoton

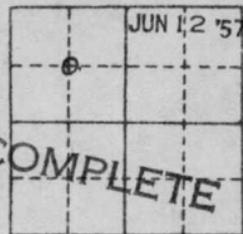

Date Comm. _____
 Location, WOOR MAY 15 '57 MAY 22 '57 5-20-57

MAY 29 '57 8 7/8 974 1600 Rng
5 1/2 JUN 5 '57 5 1/2 2584 1800
CO 2578 30 2570-73 FRAC
5x5 ga 2,466 MCFG + 28
cuph JUN 12 '57 PB 2553 40/2546
-51 FRAC CO 2578 ga
2,470 MCFG 20" of Flow
ga 5,300 MCFG PP
SIP 353H