


Stafford

KANSAS

Section 26 Township 24 Range 11-W

Well No. 1 F. H. Paulson

Company Stanolind et al

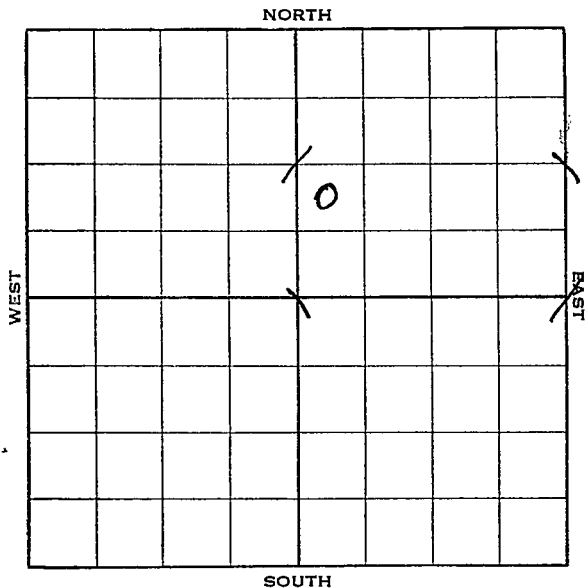

Sec. 26 Twp. 24 R. 11-W

Well No. #1 F. H. Paulson Farm

Starolind et al Company


 Ft. from N. Line

990 Ft. from S. Line

 Ft. from E. Line

330 Ft. from W. Line

Elev. 1787

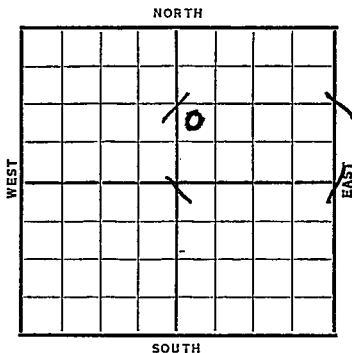

Date	REPORT
1938	
3/2	Location
3/11	10" @ 272'. WOC.
3/18	Anhy 515'. Drlg. 1985'.
3/25	Drlg. 3080'.
4/1	Lans. 3393'. Coring 3819'.
4/8	Base Kinderhook 3821'.
	Misner & 7" @ 3825'.
	T.D. 3833'. S. O. RUST.
4/15	" " " " "
4/22	1500' water in 5 hrs. S.O.
	S.D.O.
4/29	Viola 3836'. Drlg. 3921'.
5/6	Drlg. 3994'.
5/12	T.D. 4020' SD.
5/18	7" @ 3825'.
	Misner 3825'.
	T.D. 4020'.
	ABANDONED

Map No. 47 Sec. 26 Twp. 24 R. 11WWell No. I. E. H. PaulsonStanolind etal Company

Contractor

FIRST REPORT

NW SW NE

 Ft. from N. Line990 Ft. from S. Line Ft. from E. Line330 Ft. from W. Line

SECTION PLAT

		/ 0	

Location XRig up

Drilling and Remarks:

RECORD

Cased in., ft.Sand Gas Oil Total Depth

PRODUCTION

1st 24 hrs. Nat. 1st 24 hrs. after shot Gas Cu. Ft.Dry Hole Abandoned

Date

MAR 2 - 1938 19 H. D. Hatfield Scout

