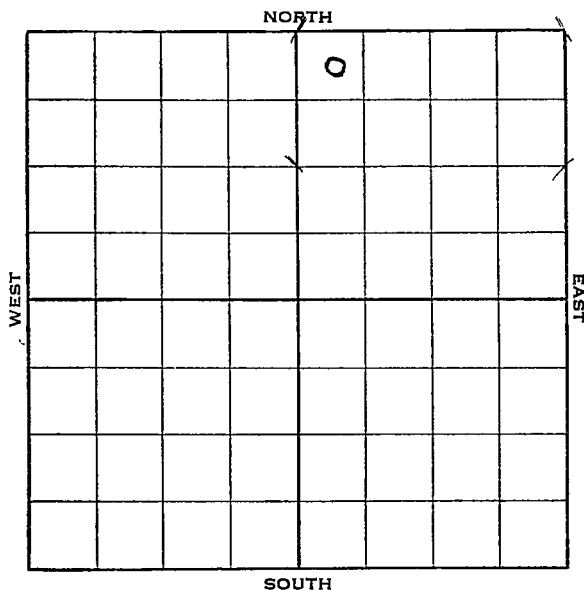


Section 26 Township 24 Range 11-NWell No. 1 H. C. Paulson "B"Company Stanolind et al

1938

4/6 6" @ 3809'.

Misner 3808'.

T.D. 3810'.

Potential 473 oil & 3 water.

COMPLETED

Map No. 47 Sec. 26 Twp. 24 R. 11WWell No. 1 H. C. Paulson "B"Stanolind etal Company


Contractor

FIRST REPORT

NW NE

330 Ft. from N. Line Ft. from S. Line Ft. from E. Line330 Ft. from W. Line

SECTION PLAT

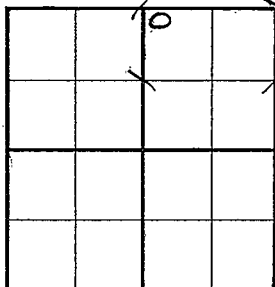Location XRig up

Drilling and Remarks:

RECORD

Cased in., ft.Sand Gas Oil Total Depth

PRODUCTION

1st 24 hrs. Nat. 1st 24 hrs. after shot Gas Cu. Ft.Dry Hole Abandoned

Date

FEB 2 1938 19 H. D. Hatfield Scout

Stafford **KANSAS**Map No. 47 Sec. 26 Twp. 24 R. 11WWell No. 1 H. C. Paulson "B"Stanolind etal

Company

Contractor

COMPLETED

NW NE

330 Ft. from N. Line Ft. from S. Line Ft. from E. Line330 Ft. from W. Line**SECTION PLAT**

		0	

Location Rig up

Drilling and Remarks:

POT 473 oil
3 wtr

RECORDCased 6 in. 3809 ft.Sand Misner 3808Gas Oil Total Depth 3810**PRODUCTION**1st 24 hrs. Nat. 1st 24 hrs. after shot Gas Cu. Ft.Dry Hole Abandoned

Date

APR 6 - 1938 19H. D. Hatfield Scout