


Section 26 Township 24 Range 12W

Well No. #2 Jordan

Company W. L. Hartman

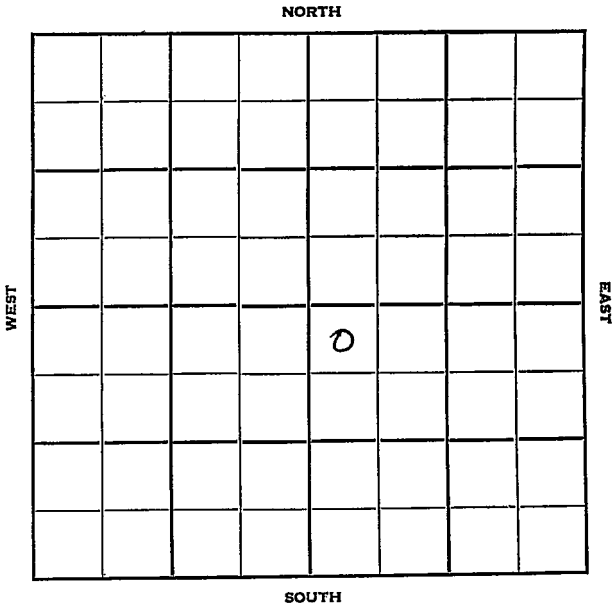

Stafford

KANSAS

Sec. 26 Twp. 24 R. 12 W ✓

Well No. # 2 Jordan Farm

W. L. Hartman Company

Contractor


Wildcat

230 Ft. from N. Line

_____ Ft. from S. Line

_____ Ft. from E. Line

330 Ft. from W. Line

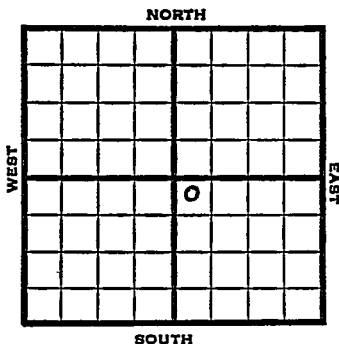

NW NW SE

1951

Elev. 1876' REPORT

2/14

MM

7/3

Spud 2-13-51

D&A TD 3530

8" @ 173

Lans. 3507 Br Lime 3479

Heeb. 3327

TD 3512 5" @ 3509

F/1 boph DD 3530 S/25 bo 120 bw

12 hr D&A

ABANDONED .

