

KANSAS

Stafford


Section 26 Township 24 Range 12WWell No. 1 JordanCompany W.L. Hartman

Wildcat

NORTH

WEST

EAST

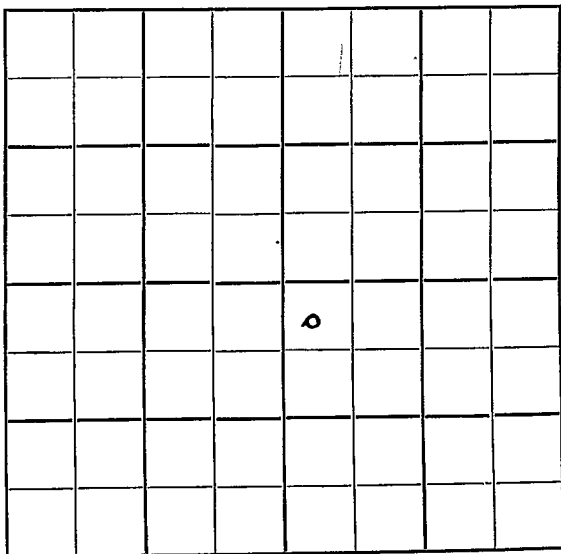

SOUTH

Stafford KANSAS

Sec. 26 Twp. 24 R. 12W

Well No. #1 Jordan Farm

W. L. Hartman Company

Wildcat


330' Ft. from N. Line

_____ Ft. from S. Line

_____ Ft. from E. Line

330' Ft. from W. Line

NW SE

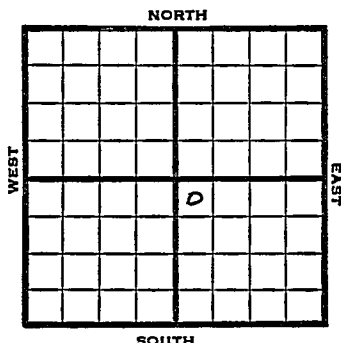

1949	Elev 1871'	REPORT
7/6	Surface Hole	
7/12	8" @ 250'	
	Drlg. 2510'	
7/20	Lansing 3507'	
	Drlg 3870'	
7/27	Viola 3936'	
	Simp 4039'	
	Arb. 4100'	
	TD 4132'	
	5"@ 3745'	
8/3	"	
8/10	"	
8/17	"	
8/24	TD 4132'	
	Arb. 4100'	
	Aband.	
	ABANDONED	

Kansas

Map No. _____ Sec. 26 Twp. 24 R. 12WWell No. 1 Jordan

W. L. Hartman _____ Company


Hartman _____ Contractor

NW SE

FIRST REPORT
SECTION PLAT330 Ft. from N. Line

_____ Ft. from S. Line

_____ Ft. from E. Line

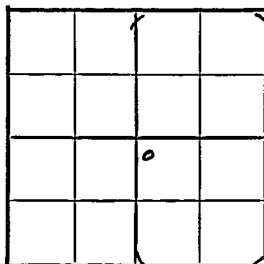330 Ft. from W. Line

Stafford County

Location _____

Rig up _____

Drilling and Remarks:

surface hole

RECORD

Cased _____ in., _____ ft.

Sand _____

Gas _____

Oil _____

Total Depth _____

PRODUCTION

1st 24 hrs. Nat. _____

1st 24 hrs. after shot _____

Gas _____ Cu. Ft.

Dry Hole _____

Abandoned _____

Date

JUL 6 1949 19

S. J. LEWIS _____ Scout

Map No. K217 Sec. 26 Twp. 24 R. 12W

Well No. 1 Jordan

W. L. Hartman Company

ABANDONED

Contractor

NW SE


E 1/8
SECTION PLAT

330 Ft. from N. Line

 Ft. from S. Line

 Ft. from E. Line

330 Ft. from W. Line

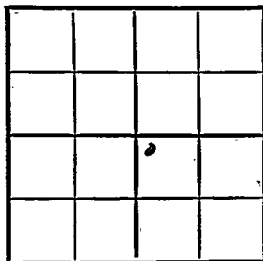

Stafford County

Location

Rig up

Drilling and Remarks:

Cor 4100
1

RECORD

Cased in., ft.

Sand

Gas

Oil

Total Depth 4132

PRODUCTION

1st 24 hrs. Nat.

1st 24 hrs. after shot

Gas Cu. Ft.

Dry Hole

Abandoned

Date

AUG 24 1949 19

S. J. LEWIS Scout