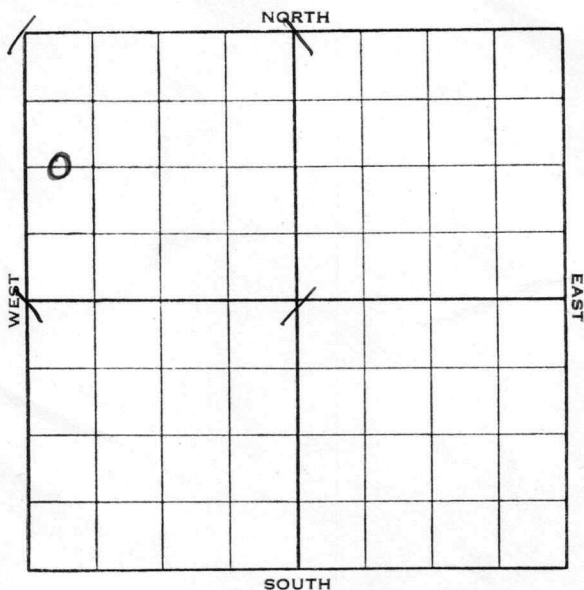


O.W.D.D.

Stafford

KANSAS

Section 26 Township 24 Range 13-WWell No. 1 AllanderCompany Thompson & Harris
~~Atlantic & Phillips~~

O.W.D.P. KANSAS

Stafford KANSAS ✓


Sec. 26 Twp. 24 R. 13-WWell No. #1 Allander Farm
Thompson & Harris
Atlantic & Phillips CompanySt. John Pool1320 Ft. from N. Line

Ft. from S. Line

Ft. from E. Line

330 Ft. from W. LineC W/2 W/2 NW

Elev. 1931

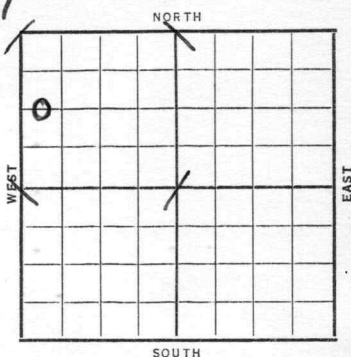

Date

REPORT

1938

3/23

R. R.

4/1

10" @ 464'.

WOC.

4/8

Drl g. 2875'.

4/15

K. C. 3580'. Cong. 3934'.

Drlg. 3937'.

4/22

Viola 3953'. Simp. 4066'.

Arb. 4114-17' T.D. S.O.

7" @ 4114'. RUST.

4/29

Drilled plug. 600' oil in 4 hrs.

1000 acid. Swab 3 fluid per hr.

2000 acid.

5/6

T.D. 4119'. Testing.

OVER

1938

5/10

7" @ 4114'.

Arb. 4114'.

T.D. 4119'.

2000 acid.

Potential 747 bbls.

9% water.

COMPLETED

O. W. D. D

1953

5/13

KC 3580' Cong 3934'

Viola 3953

Simp. 4066 Arb 4114

OTD 4119

DD 4121'

5/21

N.R.

5/28

NR

6/3

NR

7/1

Oil Well

TD 4124

KC 3580, Cong 3934, Viola 3953, Simp
4066, Arb 4114

OTD 4119

DD 4121, DD 4124

Comp 59 bopd 96% wtr.

Stafford KANSAS

Map No. 83 Sec. 26 Twp. 24 R. 13WWell No. 1 AllanderAtlantic & Phillips Company


Contractor

FIRST REPORT

C W L NW

1320 Ft. from N. Line Ft. from S. Line Ft. from E. Line330 Ft. from W. Line

SECTION PLAT

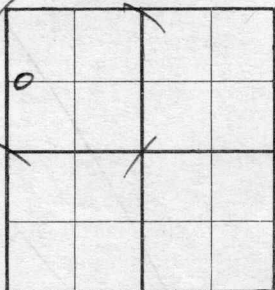Location Rig up

Drilling and Remarks:

RR

RECORD

Cased in., ft.Sand Gas Oil Total Depth

PRODUCTION

1st 24 hrs. Nat. 1st 24 hrs. after shot Gas Cu. Ft.Dry Hole Abandoned

Date

MAR 23 1938

19

H. D. Hatfield

Scout

Stafford

KANSAS

Map No. 83 Sec. 26 Twp. 24 R. 13WWell No. 1 AllanderAtlantic & Phillips Company

Contractor

COMPLETED

C W L NW

1320 Ft. from N. Line

_____ Ft. from S. Line

_____ Ft. from E. Line

330 Ft. from W. Line

SECTION PLAT

0			

Location _____

Rig up _____

Drilling and Remarks:

*2000 acid**POT 747**~~NAT~~**970 wtr*

RECORD

Cased 7 in., 4114 ft.Sand Arb 4114

Gas _____

Oil _____

Total Depth 4119

PRODUCTION

1st 24 hrs. Nat. _____

1st 24 hrs. after shot _____

Gas _____ Cu. Ft.

Dry Hole _____

Abandoned _____

Date

MAY 10 1938


19

H. D. Hatfield Scout

J. G. McGEHEE

O. W. D. D

County Stafford State Kansas
 Sec. 26 (Blk. 24) (Sur. 13W) Map No. 13W
 Operator Thompson & Harris (was Atl & Philli)
 Well No. 1 Farm Allender
 Elev. 1931 Location C W $\frac{1}{2}$ W $\frac{1}{2}$ NW

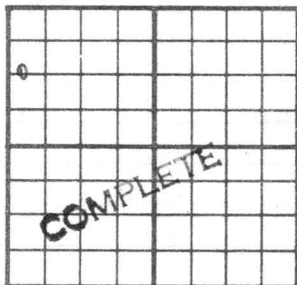

1320 Ft. From N Line NW
330 Ft. From W Line Quarter

1st. Report

Completion JUL 1 1953

Remarks

OWDD

O. W. D. D

Spudding Date

Drig. Data Oil well TD 4124
KC 3580 Cong. 3934 Viola 3953
Simp. 4066 Arb. 4114 OTD 4119
DD 4121 DD 4124 Comp. 59 bopd 96% wtr.

J. G. McGEHEE