


Section 26 Township 24 Range 13-W

Well No. #1 Allender

Company Ferrell Drlg.  
St. John Pool

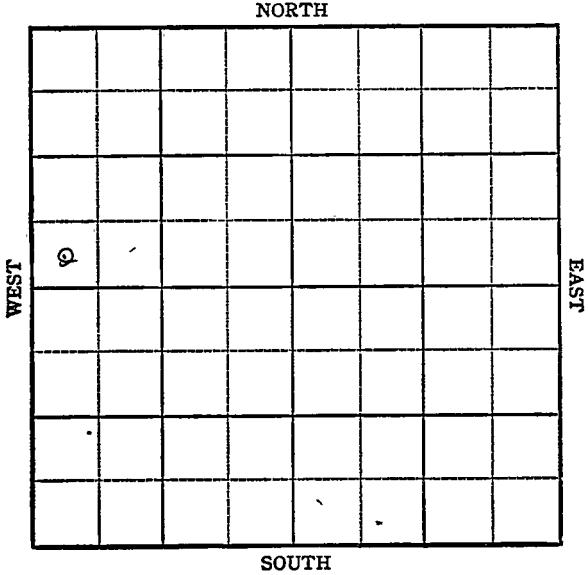

**KANSAS**

Stafford



Sec. 26 Twp. 24 R. 13W

Well No. #1 Allender Farm

Ferrell Drlg. Company

St. Johns Pool


\_\_\_\_\_ Ft. from N. Line

330' Ft. from S. Line

\_\_\_\_\_ Ft. from E. Line

330' Ft. from W. Line

SW NW

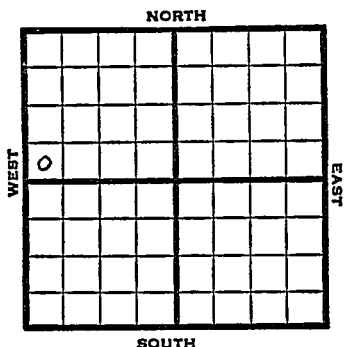

1948	Eli 1926'	<b>REPORT</b>
------	-----------	---------------

12/1	8" @ 442' Anhy 770' Drlg. 2080'
12/6	Lansing 3571' Drlg. 3750'
12/15	TD 4125' in Simp Simp 4077' Aband. <b>ABANDONED</b>

Map No. \_\_\_\_\_ Sec. 26 Twp. 24 R. 13W

Well No. 1 Allender

Ferrell Drlg. Company

FIRST REPORT Contractor

SW NW

SECTION PLAT

\_\_\_\_\_ Ft. from N. Line

330 Ft. from S. Line

\_\_\_\_\_ Ft. from E. Line

330 Ft. from W. Line


Stafford County

Location \_\_\_\_\_

Rig up \_\_\_\_\_

Drilling and Remarks:

8" @ 442

Anhy 770

drlg. 2080

RECORD

Cased \_\_\_\_\_ in., \_\_\_\_\_ ft.

Sand \_\_\_\_\_

Gas \_\_\_\_\_

Oil \_\_\_\_\_

Total Depth \_\_\_\_\_

PRODUCTION

1st 24 hrs. Nat. \_\_\_\_\_

1st 24 hrs. after shot \_\_\_\_\_

Gas \_\_\_\_\_ Cu. Ft.

Dry Hole \_\_\_\_\_

Abandoned \_\_\_\_\_

Date

DEC 1 1948

19

S. I. LEWIS Scout

