


Section 26 Township 24 Range 13-~~7~~

Well No. 1 Curtis Estate

Company Continental & Phillips .

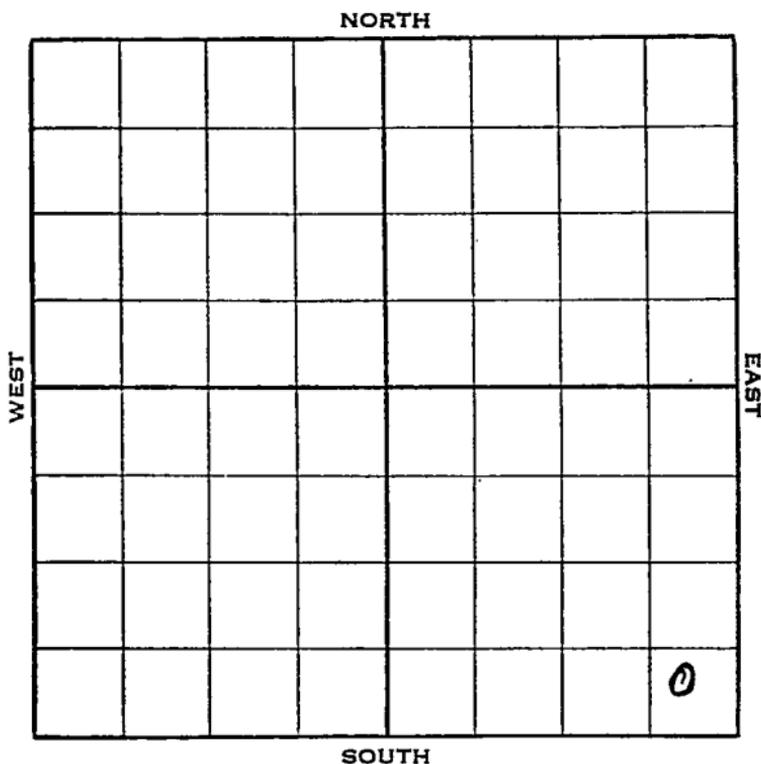

Sec. 26 Twp. 24 R. 13-W

Well No. #1 Curtis Estate Farm

Continental & Phillips Company


NORTH

\_\_\_\_\_ Ft. from N. Line

440 Ft. from S. Line

440 Ft. from E. Line

\_\_\_\_\_ Ft. from W. Line

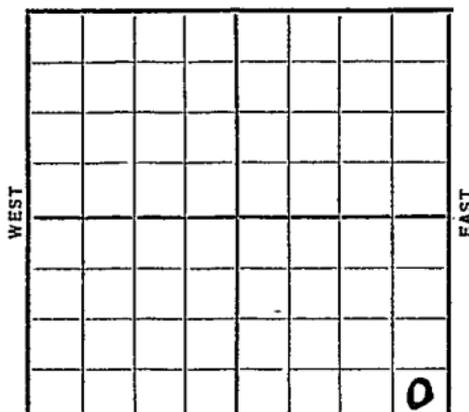

Elev. 1911

Date

REPORT

1938

3/16

B.R.R.

3/25

10" @ 452'. Anhy 762'.

Drlg. 1350'.

4/1

Drlg. 3030'.

4/8

Lans. 3585'. Drlg. 3955'.

4/15

Viola 3988'. Simpl. 4125'.

Drlg. 4182'.

4/20

Arb. 4185'.

T.D. 4191'.

Sulphur water in core.

ABANDONED

Stafford **KANSAS**

Map No. 83 Sec. 26 Twp. 24 R. 13W

Well No. 1 Curtis Estate

Continental & Phillips Company

Contractor

**FIRST REPORT**

**SECTION PLAT**

**SE/C**

\_\_\_\_\_ Ft. from N. Line

440 Ft. from S. Line

440 Ft. from E. Line

\_\_\_\_\_ Ft. from W. Line

			0

Location \_\_\_\_\_

Rig up \_\_\_\_\_

Drilling and Remarks:

**BRR**

**RECORD**

Cased \_\_\_\_\_ in., \_\_\_\_\_ ft.

Sand \_\_\_\_\_

Gas \_\_\_\_\_

Oil \_\_\_\_\_

Total Depth \_\_\_\_\_

**PRODUCTION**

1st 24 hrs. Nat. \_\_\_\_\_

1st 24 hrs. after shot \_\_\_\_\_

Gas \_\_\_\_\_ Cu. Ft.

Dry Hole \_\_\_\_\_

Abandoned \_\_\_\_\_

Date

**MAR 16 1938**

19

**H. D. Hatfield** Scout

Map No. 83 Sec. 26 Twp. 24 R. 13W

Well No. 1 Curtis Est.

Continental & Phillips Company

Contractor

ABANDONED

SE/C

\_\_\_\_\_ Ft. from N. Line

440 Ft. from S. Line

440 Ft. from E. Line

\_\_\_\_\_ Ft. from W. Line

SECTION PLAT

			0

Location \_\_\_\_\_

Rig up \_\_\_\_\_

Drilling and Remarks:

*Sulphur wtr in cor*

*DVA*

RECORD

Cased \_\_\_\_\_ in., \_\_\_\_\_ ft.

Sand *Ar-b 4185*

Gas \_\_\_\_\_

Oil \_\_\_\_\_

Total Depth *4191*

PRODUCTION

1st 24 hrs. Nat. \_\_\_\_\_

1st 24 hrs. after shot \_\_\_\_\_

Gas \_\_\_\_\_ Cu. Ft.

Dry Hole \_\_\_\_\_

Abandoned \_\_\_\_\_

Date

APR 20 1938 19

H. D. Hatfield

Scout