


Stafford **KANSAS**

SECTION 26 TOWNSHIP 24 RANGE 15 W

WELL NO. #2 Blount

COMPANY Wilcox & Henry, Durbin Bond & Lewis

NORTH

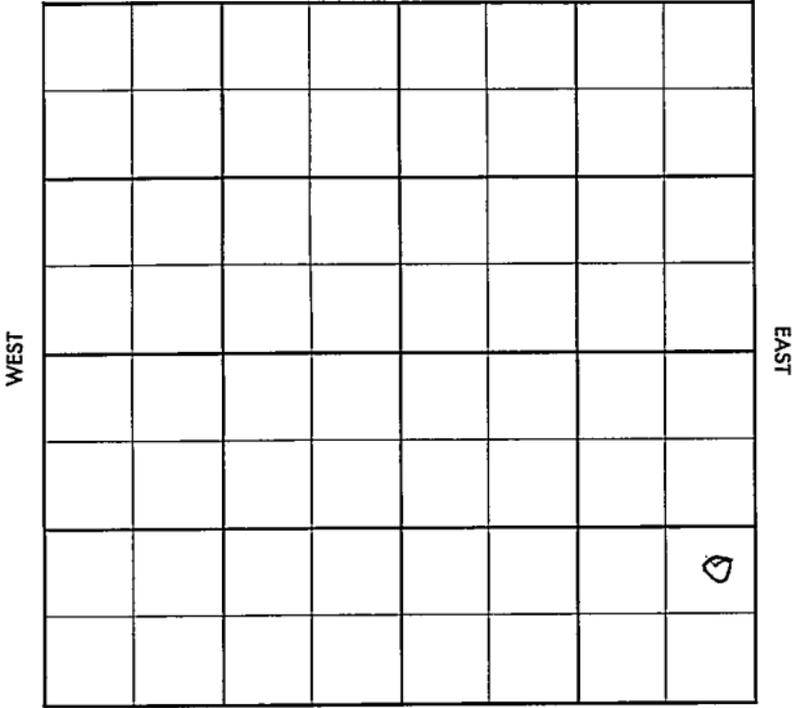

SOUTH

SEC. 26	TWP. 24	R. 15W
------------	------------	-----------

WELL NO.

#2 Blount

FARM

COMPANY

Wilcox, & Henry, Durbin Bond & Lewis

CONTRACTOR

Lewis


NE Farmington

_____ Ft. from N. Line

_____ Ft. from S. Line

_____ Ft. from E. Line

_____ Ft. from W. Line

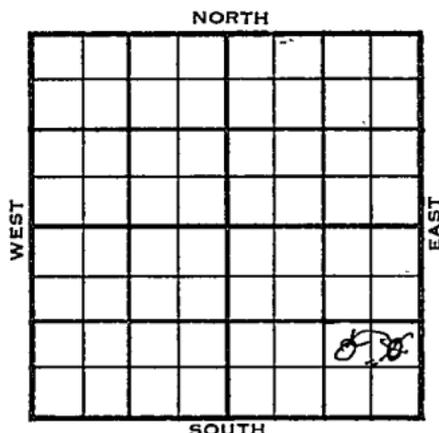~~NE SE SE NW SE SE~~SDX $\frac{1}{2}$ mile

1956	ELEVATION	REPORT
	2016 DF 2019	KB
3-7	Comm. 3-1-56 8" @ 196/175 Drlg. 3598	
3-15	Heeb. 3608, Br. lime 3756 Lans. 3770 BKC 4021 Viola 4202 Simp. 4345 Arb. 4433 TD 4438 DST 4434-38, op 1 hr. rec. 420' gas, $\frac{1}{2}$ 520' clean gassy oil, 120' ogcsw, 1480/20" 5 $\frac{1}{2}$ " @ 4434/75	
3-22	CO to 4438, FU 1200' oil, 500' wtr., 12 hrs.	
3-29	No report	
4-5	Putting on pump	
4-12	No report	
4-13	Putting on pump	
4-25	Comp. 26 bopd, 95% wtr. TD 4438'	

County Sta fford Elev. _____
 Sec. 26 Twp. 24 Rge. 15W
 Company Wilcox & Henry, Durbin Bond & Lewis
 FarmName Blount No. 2

TOPS	DEPTH	LOG	DATUM
Anb.			
TP.			
H.			
Tr.			
Dg.			
Bl.			
L.			
K.C.			
B.K.C.			
Ce.			
C.			
M.			
M.			
K.			
Mz.			
Me.			
V.			
S.			
S.			
A.			
R.			
PE.			
G.			
T.D.			

Loc. in Sec. NE SE SE
 Geol. _____
 Contr. Lewis
 Pool NE Farmington

1/2 mile	
FIRST REPORT	
MAR	7 '56
0	

Date Comm. 3-1-56
8" @ 196/175 drlg. 3598

[Handwritten signature]


Co.
Lse.
No.
Sec.
T.
R.

CORRECTION

FORM 513 REV. SUNRAY

County Stafford Elev. _____
 Sec. 26 Twp. -24 Rge. 15W
 Company Wilcox & Henry, Durbin-Bond & Lewis
 FarmName Blount No. 2

TOPS	DEPTH	LOG	DATUM	Loc. in Sec.
Anh.				NW SE SE
Tr.				
H.				
Tr.				
Dg.				
Bl.				
L.				Geol. _____
K.C.				Contr. _____
B.K.C.				
Ce.				
C.				
M.				
M.				Pool _____
K.				
Mz.				
Mq.				
V.				
S.				
S.				
A.				
R.				
Pe.				
G.				
T.D.				

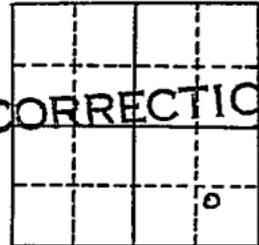

APR 25 1956

Date Comm. _____
Reported NE SE SE

Co. No. Lse. No. Sec. T. R.

2016 DF

2019 KB

County Stafford Elev. _____
 Sec. 26 Twp. 24 Rge. 15W
 Company Wilcox & Henry, Durbin Bond & Lewis
 FarmName Blount No. 2

TOPS	DEPTH	LOG	DATUM
Anh.			
Tr.			
Dg.			
Bl.	<u>3756</u>		<u>1740</u>
L.	<u>3770</u>		<u>1754</u>
K.C.			
B.K.C.	<u>4021</u>		<u>2005</u>
Ce.			
C.			
M.			
M.			
K.			
Mz.			
Me.			
V.	<u>4202</u>		<u>2186</u>
S.	<u>4345</u>		<u>2329</u>
S.			
A.	<u>4433</u>		<u>2417</u>
R.			
PE.			
G.			
T.D.	<u>4438</u>		

Loc. in Sec. _____

NW SE SE

Geol. _____

Contr. _____

Lewis

Pool _____

NE Farmington

COMPLETE

Date Comm. 3-1-56

APR 25 1956

8" @ 196/175 DST 4434-38 open 1 hr.

rec. 420' gas 520' clean gassy oil

120' ogcsw 1480/20" 5 1/2" @ 4434/75

CO to 4438 - FU 1200' oil 500' wtr.

12 hr. Comp. 26 bopd 95% wtr.