

Finney


KANSAS

SECTION 26 TOWNSHIP 24 RANGE 32W

WELL NO. #1 D. Allerman GU

COMPANY Stanolind Oil & Gas

NORTH

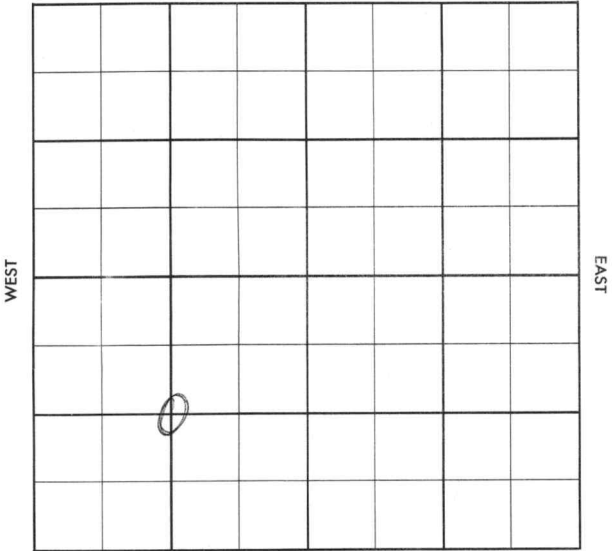

SOUTH

County Finney Elev. _____ Co.
 Sec. 26 Twp. 24 Rge. 32W
 Company Stanolind Oil & Gas
 Farm Name D. Allermard GU No. 1

TOPS	DEPTH	LOG	DATUM	Loc. in Sec.	Lse.
Anh.				C SW/4	
Tp.					
H.					
Tr.					
Dg.					
Bl.					
L.				Geol.	
K.C.				Contr.	
B.K.C.					
Ce.					
C.					
M.				Pool	
M.				Hugoton	
K.					
Mz.					
Mq.					
V.					
S.					
S.					
A.					
R.					
PE.					
G.					
T.D.					

DEC 28 1956

FIRST REPORT

Date Comm.

Location

35

Co.

County Finney Elev. 2802 DF
 Sec. 26 Twp. 24 Rge. 32W
 Company Stanolind Oil & Gas
 Farm Name D. Allerman GU No. 1

TOPS	DEPTH	LOG	DATUM	Loc. in Sec.
Anh. <u>Herr</u>		<u>2491</u>		<u>C SW/4</u>
TP. <u>KRI</u>		<u>2518</u>		
H. <u>WFD</u>		<u>2553</u>		
Tr.				
Dg.				
Bl.				
L.				Geol.
K.C.				Contr.
B.K.C.				
Ce.				
C.				
M.				Pool
M.				<u>Hugoton</u>
K.				
Mz.				
Mq.				
V.				
S.				
S.				
A.				
R.				
Pe.				
G.				
TD.	<u>2563</u>			

COMPLETE

JAN 30 '57

Lse.

No.

Sec.

T.

R.

Date Comm.

Location

JAN 2 '57

JAN 9 '57 1-2-57

8 7/8 902/650 5 1/2 @ 2558/800

JAN 15 '57 CO 2545 32/2528-36 FRAC

15 X 15 REPF 80/2503-13 FRAC

8 Ld. JAN 28 '57 16 hr BP ga 4.74

MCF + 340 GWPB Thru 7 1/2" CSG

S.I. JAN 30 '57 20" G2 FLOW ga 6.530

MCFB SIP 360 #