


KANSAS

Finney

Section 26 Township 24²⁵ Range 34WWell No. 8 BrownCompany Northern Natural Gas

Hugoton

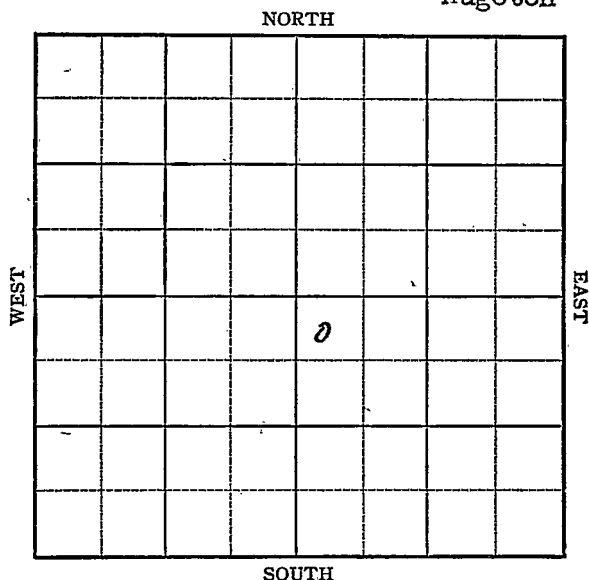

Finney

KANSAS

Sec. 26 Twp. ~~25~~ 24 R. ~~34~~ 34

Well No. #8 Brown Farm

Northern Natural Gas

Company

Hugoton Pool (Moran, Cont.)


NORTH

100' Ft. from N. Line

_____ Ft. from S. Line

_____ Ft. from E. Line

100' Ft. from W. Line

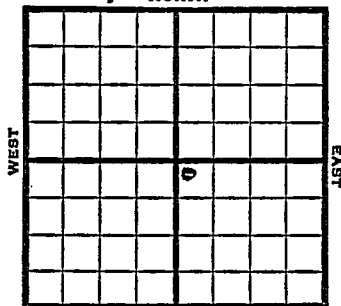

NW SE

SOUTH

1949

Elev 2963'

REPORT

5/18

Location

5/25

10" @ 494'
TD 2460'

6/1

7" @ 2442'

6/7

TD 2750'

372' of 5" Perf liner @ 2750'

6/15

Acid 15,000

6/21

"

6/28

"

7/6

TD 2750'

7" @ 2442'

372' of 5" Perf Liner @ 2750'

15000 acid

17,164,000 Gas

417# R Pr.

Comp

COMPLETED

Kansas

Map No. _____ Sec. 26 Twp. 25 R. 34W

Well No. 8 Brown

Northern Natural Gas Company

Moran Contractor

NW SE


FIRST REPORT
SECTION PLAT

100 Ft. from N. Line

_____ Ft. from S. Line

_____ Ft. from E. Line

100 Ft. from W. Line

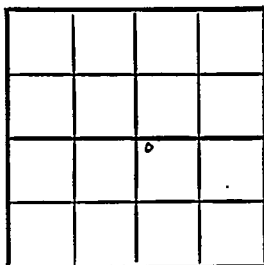

Finney County

Location X

Rig up

Drilling and Remarks:

RECORD

Cased _____ in., _____ ft.

Sand _____

Gas _____

Oil _____

Total Depth _____

PRODUCTION

1st 24 hrs. Nat. _____

1st 24 hrs. after shot _____

Gas _____ Cu. Ft.

Dry Hole _____

Abandoned _____

Date

MAY 18 1949 19

S. J. LEWIS Scout

Map No. _____ Sec. 26 Twp. 24 R. 34W

Well No. 8 Brown

Northern Natural Gas Company

CORRECTION Contractor

NW SE

SECTION PLAT

100 Ft. from N. Line

_____ Ft. from S. Line

_____ Ft. from E. Line

100 Ft. from W. Line

		o	

Finney County

Location _____

Rig up _____

Drilling and Remarks:

Reported

26-25-34W

RECORD

Cased _____ in., _____ ft.

Sand _____

Gas _____

Oil _____

Total Depth _____

PRODUCTION

1st 24 hrs. Nat. _____

1st 24 hrs. after shot _____

Gas _____ Cu. Ft.

Dry Hole _____

Abandoned _____

Date

MAY 25 1949 19

S. J. LEWIS

Scout

Kansas

Hugoton Pool

Map No. 1 Sec. 26 Twp. 24 R. 34^WWell No. 8 BrownNorthern Natural Gas Company**COMPLETE**

Contractor

NW SE

E12943

SECTION PLAT

100 Ft. from N. Line Ft. from S. Line Ft. from E. Line100 Ft. from W. Line

		8	

Finney County

Location Rig up

Drilling and Remarks:

*7" C2442**372' of 5" Pipe line**C2750**15000 acust**17,164,000 Gas**417 R/A***RECORD**Cased in., ft.Sand Gas Oil Total Depth 2750**PRODUCTION**1st 24 hrs. Nat. 1st 24 hrs. after shot Gas Cu. Ft.Dry Hole Abandoned

Date

JUL 6 1949 19S. J. LEWIS Scout