

Map No. 27Well No. #8

KANSAS

Sec. 27Typ. 24R. 5^W

Farm


Company

Schrock
Derby Oil

NORTH

WEST

EAST

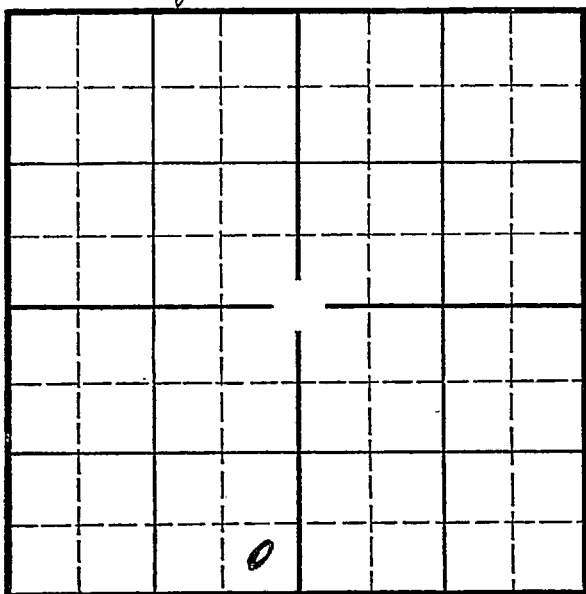

SOUTH

Location _____
Drilling Remarks _____Rig Up _____
Drilling Remarks _____

RECORD

Cased _____ in. _____ ft.
 Sand _____
 Gas _____
 Oil _____
 Total Depth _____

PRODUCTION

1st 24 hrs. Nat. _____
 1st 24 hrs. after shot _____
 Gas _____ cu. ft. _____
 Dry Hole _____
 Abandoned _____

Map No. KANSAS Sec. 27 Twp. 24 R. 5^W
Well No. #8 Schrock Farm _____
Perby Oil Company _____


_____ Ft. from N. Line

330 Ft. from S. Line

330 Ft. from E. Line

_____ Ft. from W. Line

Elev. 1546

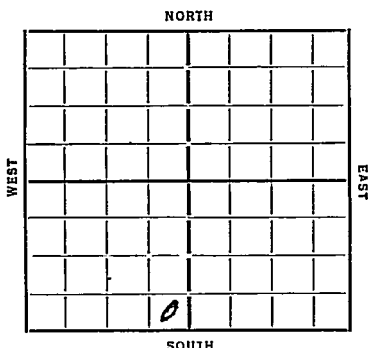

Date 1935 REPORT

11/13 Cellar
11/12 _____
11/29 15 1/2 170 woc
12/6 slg 900 18" 504
12/13 " 2460
12/19 " 3219
12/26 Top Miss 3402
1/2/36 TD 3503 sho or H w/c pipe
1/2/36 Base Miss 3621
1/10 sho oil 3760-67" TD 3777
1/17 7" 3848 TD 3870 Rust
1/17 TD 3878 HFW SP.
2/24 AB 3850 ripped pipe 3826-36
2/24 HFW Cemented off
2/24 Will deeper
1/31 T oil 3943 slg 3951
2/7 TD 3965 sho w/c AB 3812
2/7 perf. pipe 3453
2/7 10 bbls w/c per hr
2/7 Recum pipe

OVER

2/14 TD 3485
perf pipe 3465
Swabbed 1 1/2 Barrels Oil
56 Baril wtr per hr
perf pipe 3465-70
testg

2/21 perf pipe 3238-40 testg

2/26 Lil 3943
TD 3965
PB 3812
Perf. pipe
Pot 33 Oil
147 water.

COMPLETED

Map No. 40 Sec. 27 Twp. 24 R. 5W

Well No. 1- Schrock

Herby Oil Company

Contractor

FIRST REPORTS

Ft. from N. Line

330 Ft. from S. Line

330 Ft. from E. Line

Ft. from W. Line

SECTION PLAT

Location

Rig up

Drilling and Remarks:

clear

RECORD

Cased in., ft.

Sand

Gas

Oil

Total Depth

PRODUCTION

1st 24 hrs. Nat.

1st 24 hrs. after shot

Gas Cu. Ft.

Dry Hole

Abandoned

Date

11-13-35 192 Scout

KANSAS

Map No. 40 Sec. 27 Twp. 24 R. 5W

Well No. 8-Schrock

Derby Oil Company

Contractor

SE SW

CORRECTION

Ft. from N. Line

330 Ft. from S. Line

330 Ft. from E. Line

Ft. from W. Line

SECTION PLAT

CORRECTION

Location

Rig up

Drilling and Remarks:

#1 Schrock
has been changed
to #8

RECORD

Cased in, ft.

Sand

Gas

Oil

Total Depth

PRODUCTION

1st 24 hrs. Nat.

1st 24 hrs. after shot

Gas Cu. Ft.

Dry Hole

Abandoned

Date

1-15-36 192 O. Mannschreck Scout

Map No. 40 Sec. 27 Twp. 24 R. 5W

Well No. S. Schrock

Derby Company

Contractor

COMPLETED

SECTION PLAT

.....Ft. from N. Line

320 Ft. from S. Line

330 Ft. from E. Line

.....Ft. from W. Line

	0		

Location.....

Rig up.....

Drilling and Remarks:

P.B. 3812

Perfor. pipe

1st 33 oil
147 water

RECORD

Cased.....in.,ft.

Sand 514 3943

Gas.....

Oil.....

Total Depth 3965

PRODUCTION

1st 24 hrs. Nat.....

1st 24 hrs. after shot.....

Gas.....Cu. Ft.

Dry Hole.....

Abandoned.....

Date FEB 26 1936

ORVAL MANNSCHRECK

.....192.....Scout