

Map No. **KANSAS**Sec. **27**Twp. **24**R. **5th**Well No. **15 Schrock**

Farm

Company

NORTH

WEST

EAST

SOUTH

Location

Drilling Remarks

Rig Up

Drilling Remarks

RECORD

Cased _____ in. _____ ft.

Sand _____

Gas _____

Oil _____

Total Depth _____

PRODUCTION

1st 24 hrs. Nat. _____

1st 24 hrs. after shot _____

Gas _____ cu. ft. _____

Dry Hole _____

Abandoned _____

Reno

Map No. 27 Sec. 24 Twp. 5W

Well No. 1- Schrock Farm
Mc Pherson Kelly et al Company


Ft. from N. Line

330 Ft. from S. Line

Ft. from E. Line

330 Ft. from W. Line

Elev. 1525

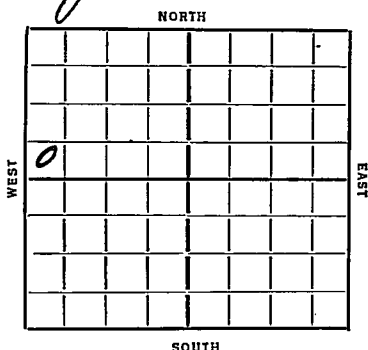

REPORT

1936
2/5 B. Rot Rig
2/14 Rgn
2/21 —
2/28 Dlg 1080 15" 130
3/6 " 2180
3/13 Drlg. 3066
3/20 T.Chat 3367 3367 7"-3412 WOC.
3/27 S.O. and 700,000 gas 3420-34
T.D. 3462I Reaming.
4/2 Drlg. 3650'
4/10 Drlg. 3796 Viola 3778'
4/16 Wilcox 3804' T.D. 3806'- 3BW.
4/23 3834' T.D. Shut down.
4/30 Wilcox 3796'. S.D. 3805' HFW.
Drlg. 3832'.
5/7 Drlg. 3907'.
5/13/36 Sil. 3897'.
T.D. 3918'.
HFW D.&.A.
ABANDONED

KANSAS

Map No. 40 Sec. 27 Twp. 24 R. 5W

Well No. 1-Schrock

McPherson Drilling Company

Contractor

SECTION PLAT

.....Ft. from N. Line

330 Ft. from S. Line

.....Ft. from E. Line

330 Ft. from W. Line

FIRST REPORT

0			

Location.....

Rig up.....

Drilling and Remarks:

B. Rot. Rig

RECORD

Cased.....in.,ft.

Sand.....

Gas.....

Oil.....

Total Depth.....

PRODUCTION

1st 24 hrs. Nat.....

1st 24 hrs. after shot.....

Gas.....Cu. Ft.

Dry Hole.....

Abandoned.....

Date

FEB 5 1936

ORVAL MANNSCHRECK

192.....Scout

KANSASMap No. 40 Sec. 27 Twp. 24 R. 5WWell No. 1 SchrockMcPerson Drilling Company

Contractor

SECTION PLAT

0			

_____ Ft. from N. Line

330 Ft. from S. Line

_____ Ft. from E. Line

330 Ft. from W. Line**ABANDONED**

Location _____

Rig up _____

Drilling and Remarks:

Oil 3897HFWJYH**RECORD**

Cased _____ in., _____ ft.

Sand _____

Gas _____

Oil _____

Total Depth 3918**PRODUCTION**

1st 24 hrs. Nat. _____

1st 24 hrs. after shot _____

Gas _____ Cu. Ft.

Dry Hole _____

Abandoned _____

Date

MAY 13 193619S. J. LEWIS

Scout