


Section 27 Township 24 Range 5-W

Well Number 1 Yoder

Company Driller's Gas.

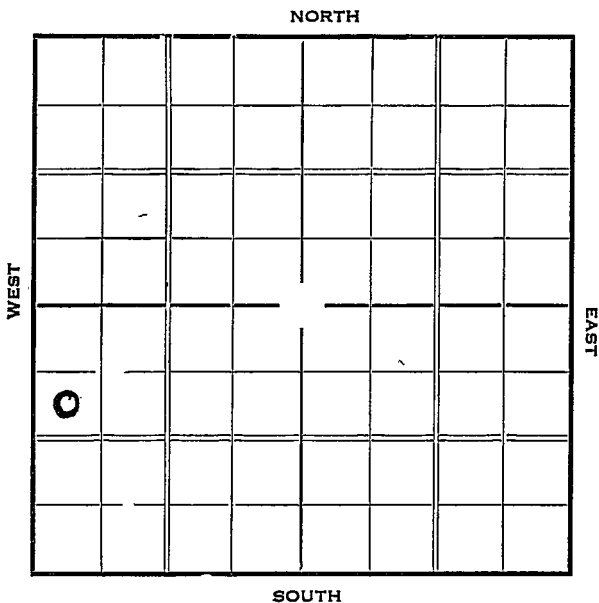

Sec. 27 Twp. 24 R. 5-W

Well No. #1 Yoder Farm


Driller's Gas Company

990 Ft. from N. Line

_____ Ft. from S. Line

_____ Ft. from E. Line

330 Ft. from W. Line

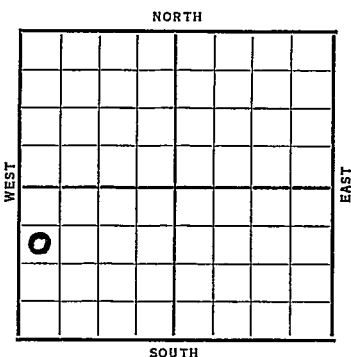

Elev. 1533

Date	REPORT
1937	
4/21	Rigging up
4/30	12" @ 144'. Drlg. 750'.
5/7	Drlg. 2038'.
5/14	Drlg. 3215'.
5/21	Chat 3382'. 7" @ 3385'.
5/28	" " " "
6/4	S. G. 3390'. S.O. 3447'.
	Drlg. 3448'.
6/9	7" @ 3385'.
	Chat 3382'.
	T.D. 3450'.
	6 M. Cu. Ft. gas.
	COMPLETED

KANSAS *Revo*Map No. _____ Sec. *27* Twp. *24* R. *5W*Well No. *1 Yoder**Triller's Gas* Company

Contractor _____

SECTION PLAT

o			

990 Ft. from N. Line

_____ Ft. from S. Line

_____ Ft. from E. Line

880 Ft. from W. Line

FIRST REPORT

Location _____

Rig up _____

Drilling and Remarks:

Rigging up

RECORD

Cased _____ in., _____ ft.

Sand _____

Gas _____

Oil _____

Total Depth _____

PRODUCTION

1st 24 hrs. Nat: _____

1st 24 hrs. after shot _____

Gas _____ Cu. Ft.

Dry Hole _____

Abandoned _____

Date

APR 21 1937 19

S. J. LEWIS Scout

Reno KANSAS

Map No. 40 Sec. 27 Twp. 24 R. 5^w

Well No. 1 - Yoder

Drillers Gas Company

Contractor

COMPLETED

SECTION PLAT

990 Ft. from N. Line

 Ft. from S. Line

 Ft. from E. Line

330 Ft. from W. Line

Location _____

Rig up _____

Drilling and Remarks:

6 M. Cu. ft gas

RECORD

Cased 7 in., 3385 ft.

Sand Chat 3382

Gas _____

Oil _____

Total Depth 3450

PRODUCTION

1st 24 hrs. Nat. _____

1st 24 hrs. after shot _____

Gas _____ Cu. Ft.

Dry Hole _____

Abandoned _____

Date

JUN 9 1937

19

H. D. Hatfield

Scout