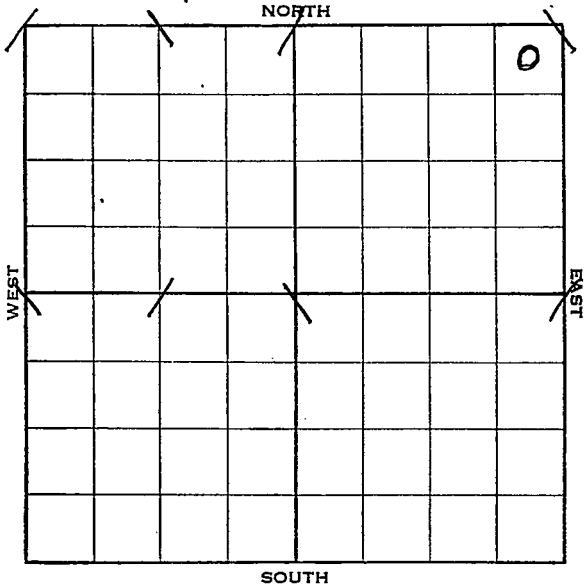
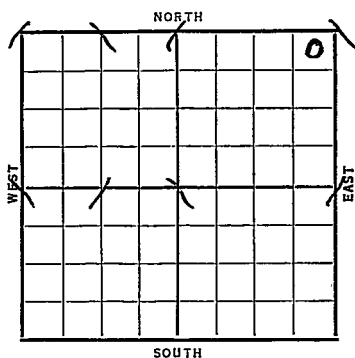


Stafford

Section 27 Township 24 Range 11-WWell No. 1 Ray McCombCompany Stanolind2044
223 7

Sec. 27 Twp. 24 R. 11-WWell No. #1 Ray McComb FarmStanolind Company330 Ft. from N. Line Ft. from S. Line330 Ft. from E. Line Ft. from W. Line

Date	REPORT
1938	
3/2	R U R
3/11	13" @ 225'. Drlg. 1982'.
3/18	Anhy 533'. Lans. 3416'.
	Drlg. 3530'.
3/25	Base K. C. 3720'.
	Misner 3837'. S.S.O. 3838-39'.
	Viola 3856'. S.O. 3856-57'.
	Rng. 7" - 3840'.
4/1	7" @ 3841'. RUST.
4/8	Drlg. 3879'. 1500' wtr.
4/15	" " " " "
4/22	Drlg. 3985'.
4/27	7" @ 3841'..
	Simp. 3975'.
	Arb. 4044'.
	T.D. 4060'.
	ABANDONED

Map No. 47 Sec. 27 Twp. 24 R. 11WWell No. 1 Ray McCombStanolind

Company


Contractor

FIRST REPORT

NE /C

330 Ft. from N. Line Ft. from S. Line330 Ft. from E. Line Ft. from W. Line

SECTION PLAT

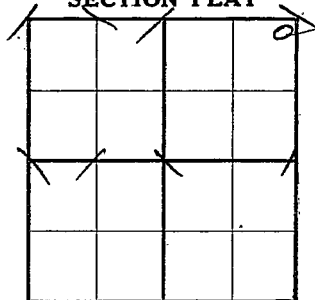Location Rig up

Drilling and Remarks:

RUR

RECORD

Cased in., ft.Sand Gas Oil Total Depth

PRODUCTION

1st 24 hrs. Nat. 1st 24 hrs. after shot Gas Cu. Ft.Dry Hole Abandoned

Date

MAR 2 - 1938

19

H. D. Hatfield

Scout

Stafford KANSAS

Map No. 47 Sec. 27 Twp. 24 R. 11WWell No. 1 Ray McCombStanolind

Company

Contractor

ABANDONED

NE/C

330 Ft. from N. Line Ft. from S. Line330 Ft. from E. Line Ft. from W. Line

SECTION PLAT

			0

Location Rig up

Drilling and Remarks:

DVA

RECORD

Cased 7 in., 3841 ft.Sand Simp 3975Gas ARB 4044Oil Total Depth 4060

PRODUCTION

1st 24 hrs. Nat. 1st 24 hrs. after shot Gas Cu. Ft.Dry Hole Abandoned

Date

APR 27 1938

19

H. D. Hatfield Scout