


Section 27 Township 24 Range 12W

Well No. #4 Byers "B"

Company C R A

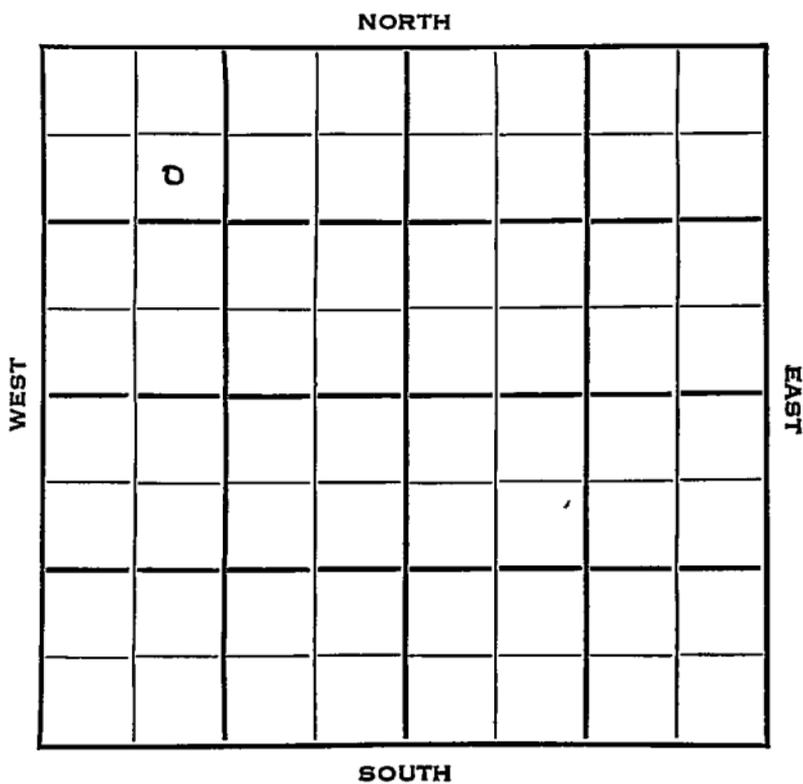


Sec. 27 Twp. 24 R. 12 WWell No. # 4 Byers "B" Farm \_\_\_\_\_C R A CompanyBud Edwards Contractor990 Ft. from N. Line

\_\_\_\_\_ Ft. from S. Line

\_\_\_\_\_ Ft. from E. Line

990 Ft. from W. Line

SE NW NW

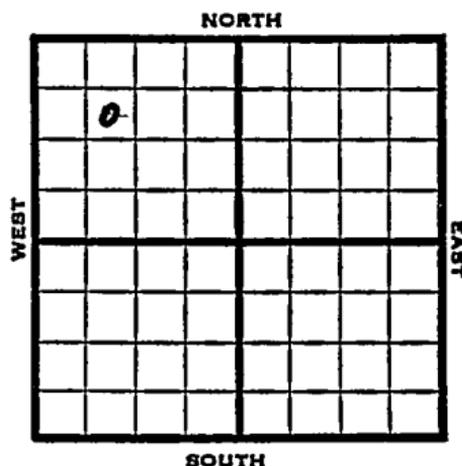

1953 Elev. 1874' REPORT

2/11 Spud 2-6-53  
8" @ 309

Drlg. 2030'

2/19 Heeb 3331, Doug 3366, Br Li  
3481, Lans 3509  
Drlg. 3770'2/26 MORM 3817 KH 3843 • @ 3919-39 20'  
shot V 3938 Simp Shale 4063 Sim Sd  
4087 Arb 4113 RTD 4163 5" @ 41293/12 DD 4198  
Drlg. 4243 for SWD

3/19 Drlg. 4361'

3/26 TD 4476'

4/2 NR

4/9 "

4/15 Spud 2-6-53

SWD well

TD 4476'

8" @ 309'

Heeb 3331, Doug 3366, Br. Lime 3481,  
Lans 3509, Marm 3817, Kh. 3843, Viola  
3938, Simp Sh. 4063, Simp sd 4087.  
Arb 4113,

OVER

1953 Information brought forward

4/15

TD 4163'

5" @ 4129'

CO to 4163

DD 4198 DD 4476

Comp. for SWD well.

**ABANDONED**



