


Section 27 Township 24 Range 13-W

Well Number 1 - Pound

Company Atlantic & Phillips

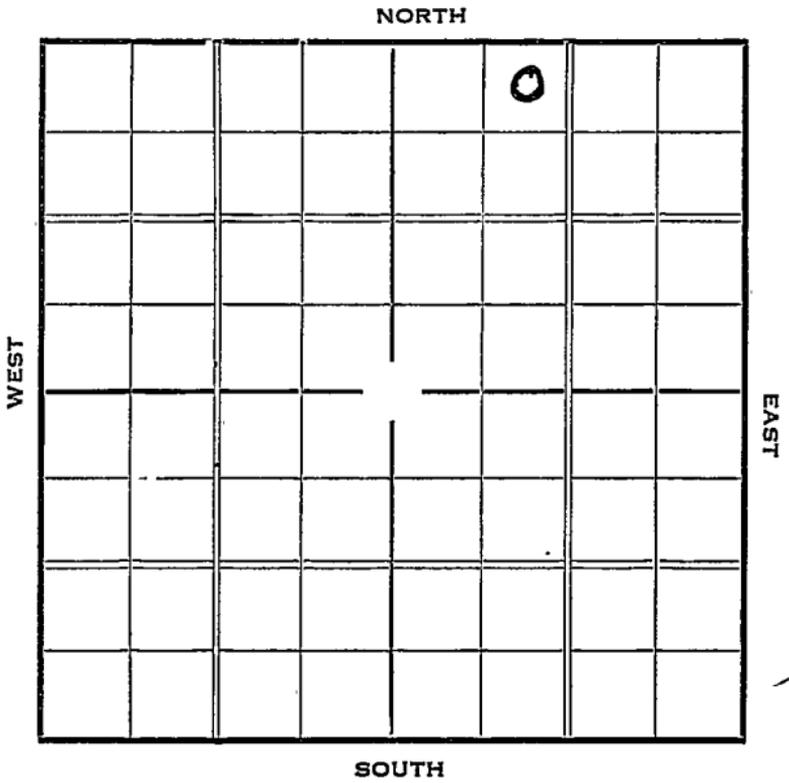

1937

6/23

7" @ 4110'.

Sil. 4111'.

T.D. 4121'.

P.B. 4119'.

Pot. 790 bbls.

S.W.

COMPLETED

Stafford KANSAS

Map No. 83 Sec. 27 Twp. 24 R. 13^W

Well No. 1-Pound

Atlantic & Phillips Company

Contractor

FIRST REPORT

SECTION PLAT

330 Ft. from N. Line
10 Ft. from S. Line
 Ft. from E. Line
990 Ft. from W. Line

		0	

Location ✓

Rig up _____

Drilling and Remarks:

RECORD

Cased _____ in., _____ ft.
 Sand _____
 Gas _____
 Oil _____
 Total Depth _____

PRODUCTION

1st 24 hrs. Nat. _____
 1st 24 hrs. after shot _____
 Gas _____ Cu. Ft.
 Dry Hole _____
 Abandoned _____

Date

MAY 10 1916 19

H. H. Hatfield Scout

Stafford KANSAS

Map No. *83* Sec. *27* Twp. *24* R. *13*

Well No. *1 - Pound*

Atlantic & Phillys Company

Contractor

SECTION PLAT

		<i>0</i>	

530 COMPLETED Ft. from N. Line

_____ Ft. from S. Line

_____ Ft. from E. Line

990 Ft. from W. Line

Location _____

Rig up _____

Drilling and Remarks:

PB 4119

Rot 790

SW,

RECORD

Cased *7* in. *4110* ft.

Sand *511 4111*

Gas _____

Oil _____

Total Depth *4121*

PRODUCTION

1st 24 hrs. Nat. _____

1st 24 hrs. after shot _____

Gas _____ Cu. Ft.

Dry Hole _____

Abandoned _____

Date

JUN 23 1937

19

H. D. Hatfield Scout