


Section 27 Township 24 Range 13 ^{TR}

Well No. #2 Pound


Company Atlantic et al

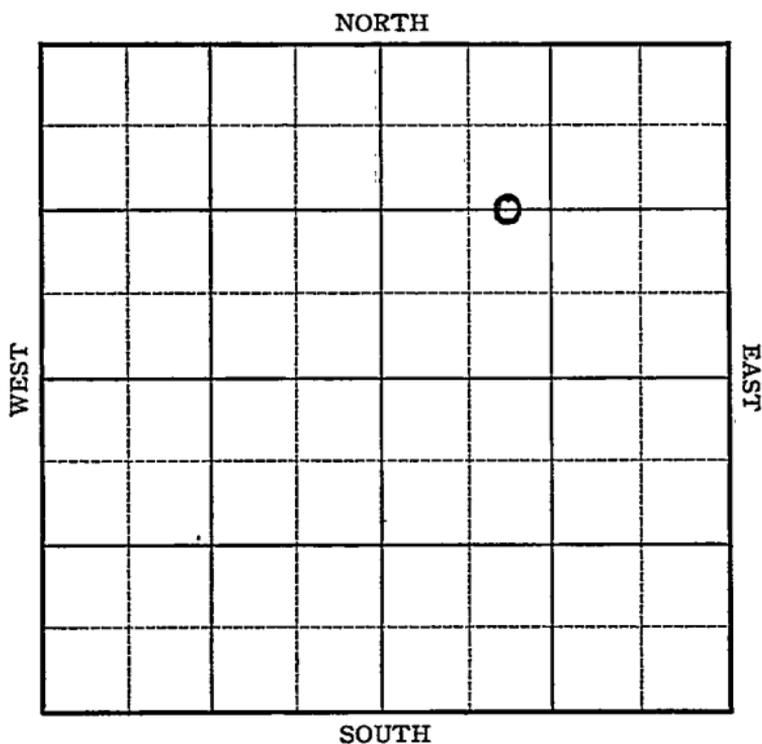

Sec. 27 Twp. 24 R. 13W

Well No. 2- Pound Farm
Atlantic etal Company

1320 Ft. from N. Line
 _____ Ft. from S. Line
 _____ Ft. from E. Line
990 Ft. from W. Line

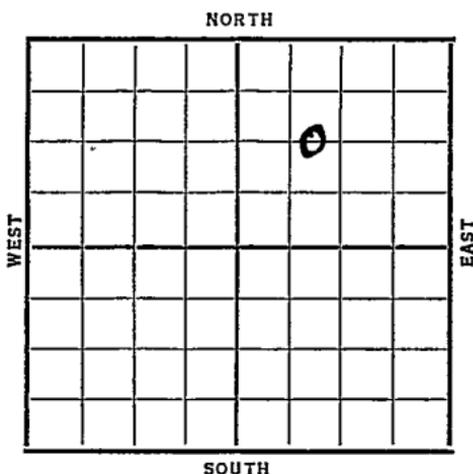

Elev. 1929

Date	REPORT
1937	
8/11	12"-408
	Anhy- 755
	Dlg. 1818
8/20	Drlg. 3350'.
8/28	Simp. 4090'. Cong. 4114'.
	Coring.
9/3	Sil. & 7" @ 4131'. T.D. 4141'.
	S.O. & Water. RUST.
9/10	T.D. 4149'. 2300' water.
	P.B. 4131'. S.D.O.
9/17	P.B. 3640'. 3200' water. SDO
9/22	Sil. 4131'.
	T.D. 4149'.
	P.B. 4131'.
	P.B. 3640'.
	ABANDONED

Stafford **KANSAS**Map No. 83 Sec. 27 Twp. 24 R. 13^WWell No. 2 - PoundAtlantic etal Company

Contractor

FIRST REPORT**SECTION PLAT**1320 Ft. from N. Line

_____ Ft. from S. Line

_____ Ft. from E. Line

990 Ft. from W. Line

		○	

Location _____

Rig up _____

Drilling and Remarks:

12"-408
Anhy-755
Dlg 1818

RECORD

Cased _____ in., _____ ft.

Sand _____

Gas _____

Oil _____

Total Depth _____

PRODUCTION

1st 24 hrs. Nat. _____

1st 24 hrs. after shot _____

Gas _____ Cu. Ft.

Dry Hole _____

Abandoned _____

Date

AUG 11 1937 19____H. D. Hatfield Scout

KANSAS

Map No. 83 Sec. 27 Twp. 24 R. 13WWell No. 2 - groundAtlantic etal

Company

Contractor

SECTION PLAT

			o

1320 Ft. from N. Line

_____ Ft. from S. Line

_____ Ft. from E. Line

990 Ft. from W. Line

ABANDONED

Location _____

Rig up _____

Drilling and Remarks:

P.B. 4131P.B. 3640D+H

RECORD

Cased _____ in., _____ ft.

Sand bl. 4131

Gas _____

Oil _____

Total Depth 4149

PRODUCTION

1st 24 hrs. Nat: _____

1st 24 hrs. after shot _____

Gas _____ Cu. Ft.

Dry Hole _____

Abandoned _____

Date

SEP 22 1937 19H. D. Hatfield

Scout