

KANSAS

Stafford

KANSAS

O. W. D. D

FORM 51 5M 10-41 PETROL

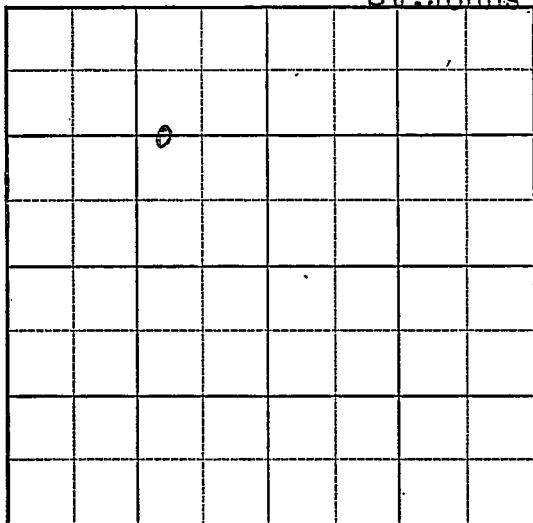
Section 27 Township 24 Range 13-WWell No. #4 ~~1~~ McNaghten ~~B~~Company Atlantic & Phillips

NORTH

St. Johns Pool

WEST

EAST



SOUTH

(St. Johns)

Ft. from W. Line

1941	REPORT
12/23	19" - 496' WOC.
12/31	Anhy 755' Ft. Riley 1980'
	Florence 2085' B. Florence 2115'
	Wreford 2170' Drlg. 2680'
1942	
1/8	Lans. 3563' S.O. 3732-37 ,
	3744-56' Drlg. 3795'
1/15	Arb. 4112-16' T.D. 5" - 4114'
	RUST.
1/22	"
1/28	Arb. 4065'
	5" - 4106'
	T.D. 4110'
	6000 acid.
	Pump 58 oil & 22 water, potential.
	37.5 Gravity
	COMPLETED
	OVER

1954
1/6

O. W. D. D

SWD well TD 4458' KC 3558'
Arb. 4105' OTD 4110' 5" @ 4106
DD 4324' DD 4458 PB 4262'
Ran 373' of $4\frac{1}{2}$ " liner of 4262
DP to 4458 Comp. for SWD well.
Input 300 BSWPH

FIRST REPORT

✓
ABANDONED

Stafford

KANSAS

Map No. 83 Sec. 27 Twp. 24 R. 13WWell No. 1 McNaghten "B"Atlantic & Phillips Company**FIRST REPORT**

Contractor

C WL E $\frac{1}{2}$ NW

SECTION PLAT

	0		

1320Ft. from N. Line Ft. from S. Line990Ft. from E. Line Ft. from W. Line**ST. JOHNS POOL**Location Rig up

Drilling and Remarks:

19" - 496'Waiting on
cement to set

RECORD

Cased in., ft.Sand Gas Oil Total Depth

PRODUCTION

1st 24 hrs. Nat. 1st 24 hrs. after shot Gas Cu. Ft.Dry Hole Abandoned

Date

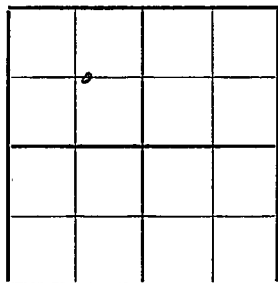
DEC 23 1941 19S. J. LEWIS Scout

Map No. 83 Sec. 27 Twp. 24 R. 13WWell No. 1 McNaghten "B"Atlantic & Phillips CompanyCOMPLETED

Contractor

C WL E $\frac{1}{2}$ NW

SECTION PLAT

1320 Ft. from N. Line Ft. from S. Line990 Ft. from E. Line Ft. from W. Line

ST. JOHNS POOL

Location Rig up

Drilling and Remarks:

*Cor 44065**5" C 4106**6000 acid**Pump 58 oil + 22**Water P 4**375 gal*

RECORD

Cased in., ft.Sand Gas Oil Total Depth 4110

PRODUCTION

1st 24 hrs. Nat. 1st 24 hrs. after shot Gas Cu. Ft.Dry Hole Abandoned

Date

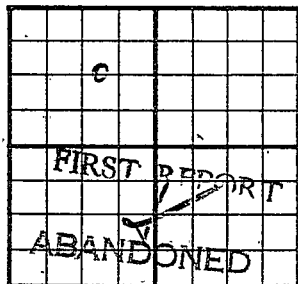
JAN 28 1942

19

S. J. LEWIS

Scout

O. W. D. D.

County Stafford State KansasSec. 27 (Blk. Twp.) 24 (Sur. Rge.) 13W Map No.Operator Atlantic Ref. & Phillips Pet.Well No. 4 Farm McNaughtonElev. 1928 Location C $\frac{1}{2}$ E $\frac{1}{2}$ NW1320 Ft. From N Line NW990 Ft. From E Line Quarter1st. Report JAN 6 1954Completion JAN 6 1954Remarks (OWDD) for SWDSpudding Date O. W. D. D.Drlg. Data SWD well TD 4458KC 3558 Arb. 4105 OTD 41105" @ 4106 DD 4324 DD 4458 PB 4262ran 373' of 4 $\frac{1}{2}$ " liner @ 4262 DP to 4458Comp. for SWD well Input 300 bswph

J. G. McGEHEE

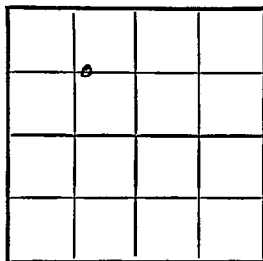
Kansas

Map No. _____ Sec. 27 Twp. 24 R. 13WWell No. 4 McNaughton "B"_____
Atlantic & Phillips Company

CORRECTION

ContractorC W L E $\frac{1}{2}$ NW

SECTION PLAT

1320 Ft. from N. Line Ft. from S. Line990 Ft. from E. Line Ft. from W. Line

Stafford County

Location _____

Rig up _____

Drilling and Remarks:

Completed

1-28-42

#1 McNaughton "B"

RECORD

Cased _____ in., _____ ft.

Sand _____

Gas _____

Oil _____

Total Depth _____

PRODUCTION

1st 24 hrs. Nat. _____

1st 24 hrs. after shot _____

Gas _____ Cu. Ft.

Dry Hole _____

Abandoned _____

Date

JAN 6 1954 19

J. G. McGEHEE

Scout